

City of Prince George HISTORY SHEET

SHEET NUMBER

Roll Number 003965-904

Legal: LOT'S 1 BLOCK _____ D.L. 937 PLAN 23003

Address: 105 LYON ST

Sanitary Connection: # 3141 SIZE 100MM MATERIAL A.C. INV. 596.757 CONNECTED

Water Connection # 324B SIZE 20MM MATERIAL CU. METER _____ CONNECTED

Storm Connection: # _____ SIZE _____ MATERIAL _____ INV. _____ CONNECTED

Cash Receipt No's: WATER _____ SANITARY _____ STORM _____

CURB FROM PROPERTY LINE 4.877M PAVEMENT WIDTH 10.363M


B.C. HYDRO O/H UNDERGROUND CONNECTION _____

B.C. TELEPHONE O/H UNDERGROUND CONNECTION _____


INLAND GAS 1.524 M FROM WEST SIDE OF LANE.

Information Sheets:

Comments: WITH THAW WIRE.

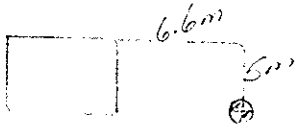

SITE PLAN N.T.S.

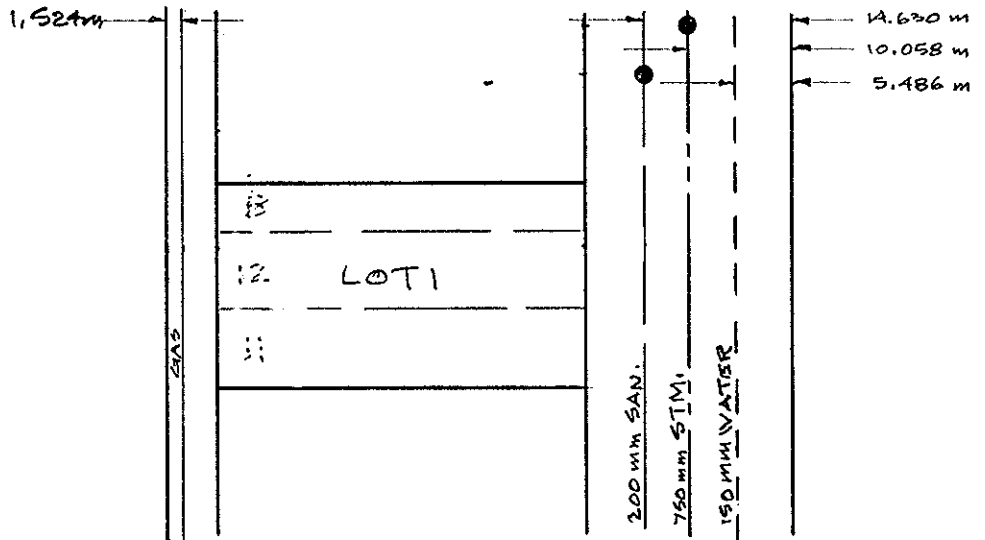

LYON ST.