

**City of Prince George
HISTORY SHEET**

003980138

SHEET NUMBER

Roll Number

Legal: LOT'S 14 BLOCK A D.L. 931 PLAN 7544

Address: 1177 CUDDIE CRESCENT

Sanitary Connection: # 5435 SIZE 100mm MATERIAL A.C.S INV. CONNECTED

Water Connection # 2557 SIZE 20mm MATERIAL Cu METER CONNECTED

Storm Connection: # SIZE MATERIAL INV. CONNECTED

Cash Receipt No's: WATER SANITARY STORM

CURB FROM PROPERTY LINE 4.877m PAVEMENT WIDTH 10.363m


B.C. HYDRO O/H UNDERGROUND CONNECTION

B.C. TELEPHONE O/H UNDERGROUND CONNECTION

INLAND GAS AS SHOWN

Information Sheets:

Comments: WITH THAW WIRE

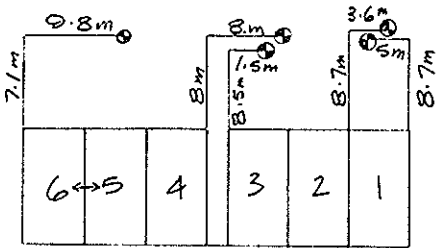

SITE PLAN N.T.S.

