

**City of Prince George
HISTORY SHEET**

003981321

SHEET NUMBER **Nº 1576** Roll Number

Legal: LOT'S **4** BLOCK **B** D.L. **936** PLAN **10005**

Address: **1656 - IRWIN ST.**

Sanitary Connection: # **4110** SIZE MATERIAL INV. CONNECTED

Water Connection # **3910** SIZE **3/4"** MATERIAL **CU** METER CONNECTED

Storm Connection: # SIZE MATERIAL INV. CONNECTED

Cash Receipt No's: WATER SANITARY STORM

CURB FROM PROPERTY LINE PAVEMENT WIDTH

B.C. HYDRO UNDERGROUND CONNECTION


B.C. TELEPHONE UNDERGROUND CONNECTION

INLAND GAS

Information Sheets:

Comments:

The information contained herein is for internal use only. Not to be relied upon unless confirmed by site inspection and/or investigation.

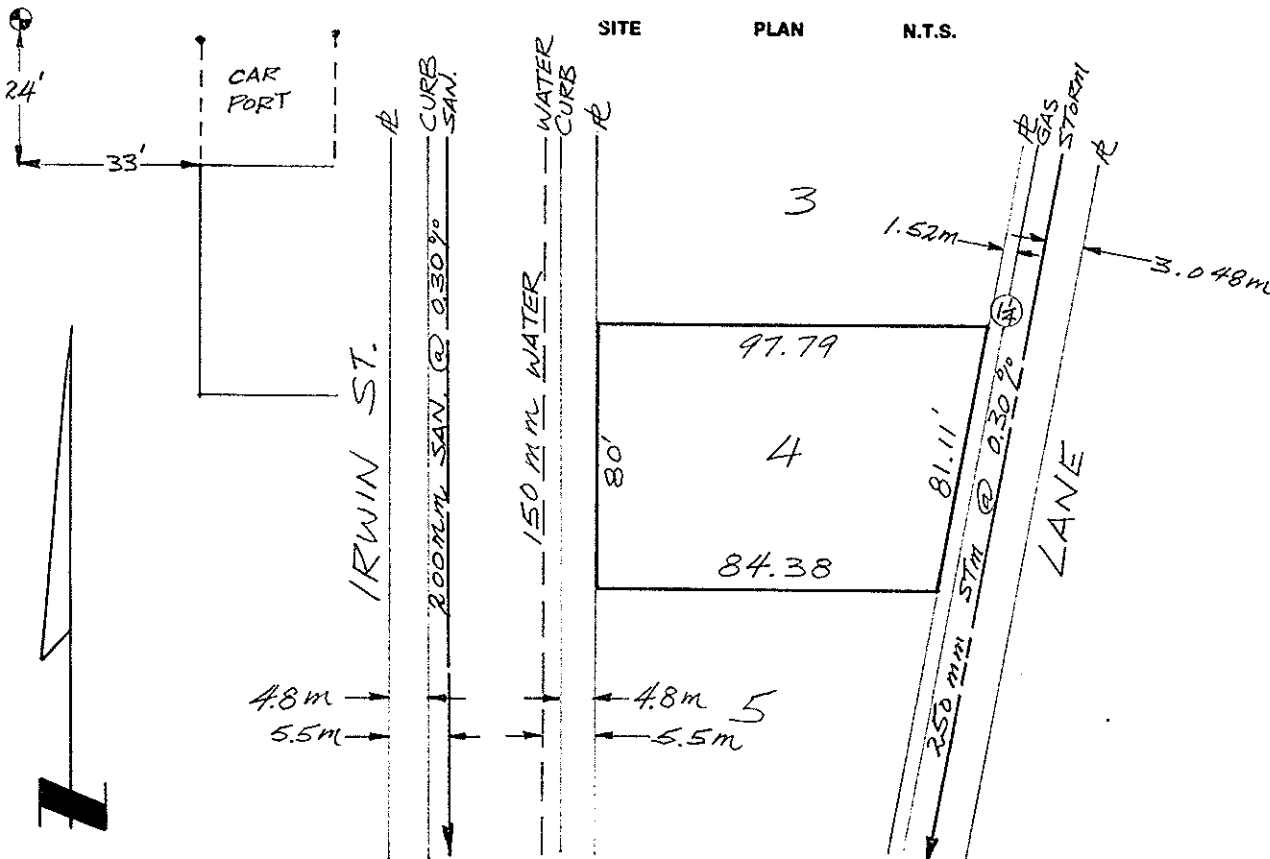

SANITARY & STORM INVERT CALCULATIONS

SANITARY

STORM

	SANITARY	STORM
1. Distance from M.H. to connection point is _____ ft. toward M.H.		
2. Calculated invert of main to conn. pt. is _____		
3. Main Size at connection point is _____ ins.		
4. Conn. invert at half diameter (Crown) of main is _____		
5. Add to (4) allowance of 0.2 for 1/8 bend. Adjusted invert now _____		
6. Dist. from main to P/L equals _____ ft. at _____ in/ft. gives rise of _____		
7. Item (5) plus (6) equals Calculated Elev. of conn. inv. at P/L equals _____		
13. Elev. of ref. hub top <u>GROUND</u>	1951.18	
14. Elev. of invert at P/line _____	1948.18	
15. Difference or cut below at property line _____	3.00	(0.914 m)
16. Survey Date <u>JUNE 25</u> 19 <u>64</u> Book Ref. <u>L 146 P. 19</u> by <u>V.G.</u>		
17. Cut at P/Line in feet and inches _____		

Sanitary History:

1' S OF N P/L DUAL CONN. PAID IN LOT PRICE

Water History:

PAID IN LOT PRICE CONN. 2' S OF N P/L.
 FEB. 4/65 TURNED ON REQUESTED BY IRWIN HOMES.
 DATE INSTALLED 1964

Storm History: