


Lot Servicing

2435 ROSS CRES

PID: 003982262 and 003982254

Lot: 16, Block: 116, Plan: 1268, DL: 343

SERVICE	SIZE	MATERIAL	INSTALLED DATE	LOCATION	DETAILS
WATER	20MM	CU		NO LOCATION–bldg demolished	CONNECTION NUMBER 7001
SANITARY	UNKNOWN	UNKNOWN		NO LOCATION	CONNECTION # 605

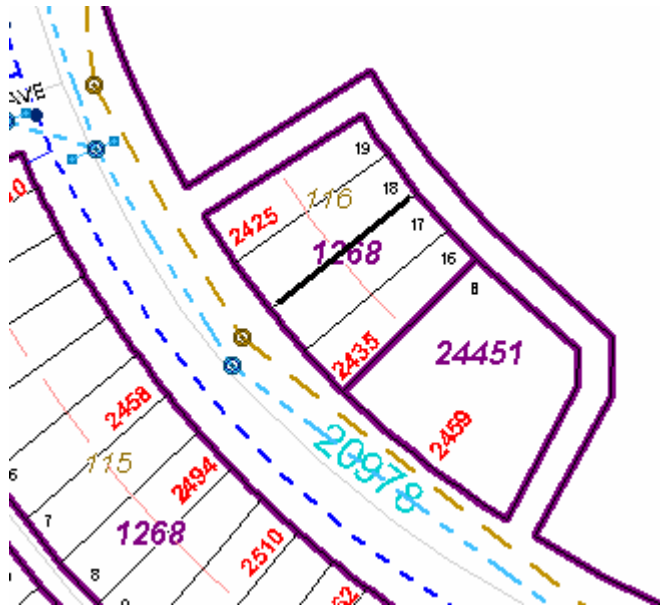

Accuracy not guaranteed unless confirmed by site inspection and/or investigation.
Connection location between main and property line only.