

**City of Prince George
HISTORY SHEET**

004004906

SHEET NUMBER

Roll Number 004004884

Legal: LOT'S B-B BLOCK 58-63 D.L. 937 PLAN 752 & 1784

Address: 395 EWERT ST

Sanitary Connection: # 1877 SIZE 100mm MATERIAL A.C. INV. _____ CONNECTED

Water Connection # 3008 SIZE 20mm MATERIAL CU METER _____ CONNECTED

Storm Connection: # _____ SIZE _____ MATERIAL _____ INV. _____ CONNECTED

Cash Receipt No's: WATER _____ SANITARY _____ STORM _____

CURB FROM PROPERTY LINE 4.877m PAVEMENT WIDTH 10.363m

B.C. HYDRO O/H UNDERGROUND CONNECTION



B.C. TELEPHONE O/H UNDERGROUND CONNECTION

INLAND GAS AS SHOWN

Information Sheets:

Comments: WITH THAW WIRE

**THE INFORMATION CONTAINED HEREIN IS FOR INTERNAL USE ONLY.
NOT TO BE RELIED UPON UNLESS CONFIRMED BY SITE INSPECTION AND/OR INVESTIGATION**

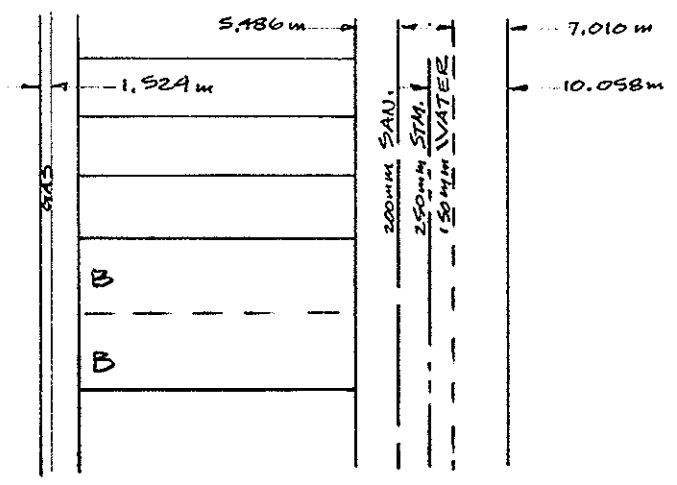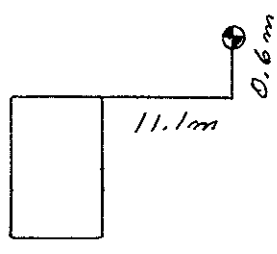

EWERT ST.