



City of Prince George  
**History Sheet**

PID:	004019431
MU:	101288
WO:	65604

Civic Address: 2244 Nicholson St

Legal Description: Lot: 11 District Lot: 8169 Plan: 16905


Service Type	Diameter (mm)	Material	Invert Elev at main (m)	Depth of Cut at property line (m)	Invert Elev at service end (m)	Distance into property (m)	Installation Date
Sanitary	100mm	PVC	-	2.92	592.92	0.00	July 1966
Water	150mm	PVC	-	-	-	-	June 2013
Storm	250mm	PVC	-	1.40	594.08	0.00	July 1972

Service Connection Location				Sanitary (m)	Storm (m)
Distance from downstream San MH	3440	towards upstream San MH	3435	64.95	
Distance from downstream Stm MH	2682	towards upstream Stm MH	2681		11.52

Power	Size	Communications	Size	Cable	Size	Gas	Size
BC Hydro	-	Telus	-	Shaw	-	FortisBC	-
Overhead Service		Overhead Service		Overhead Service			

Installed by:	City of Prince George forces	Survey Date:	-
Comments:	Existing 25mm AC water service connection abandoned - June 2013		

**NOT TO SCALE** The information contained herein is for internal use only.  
Not to be relied on unless confirmed by site inspection and/or investigation.

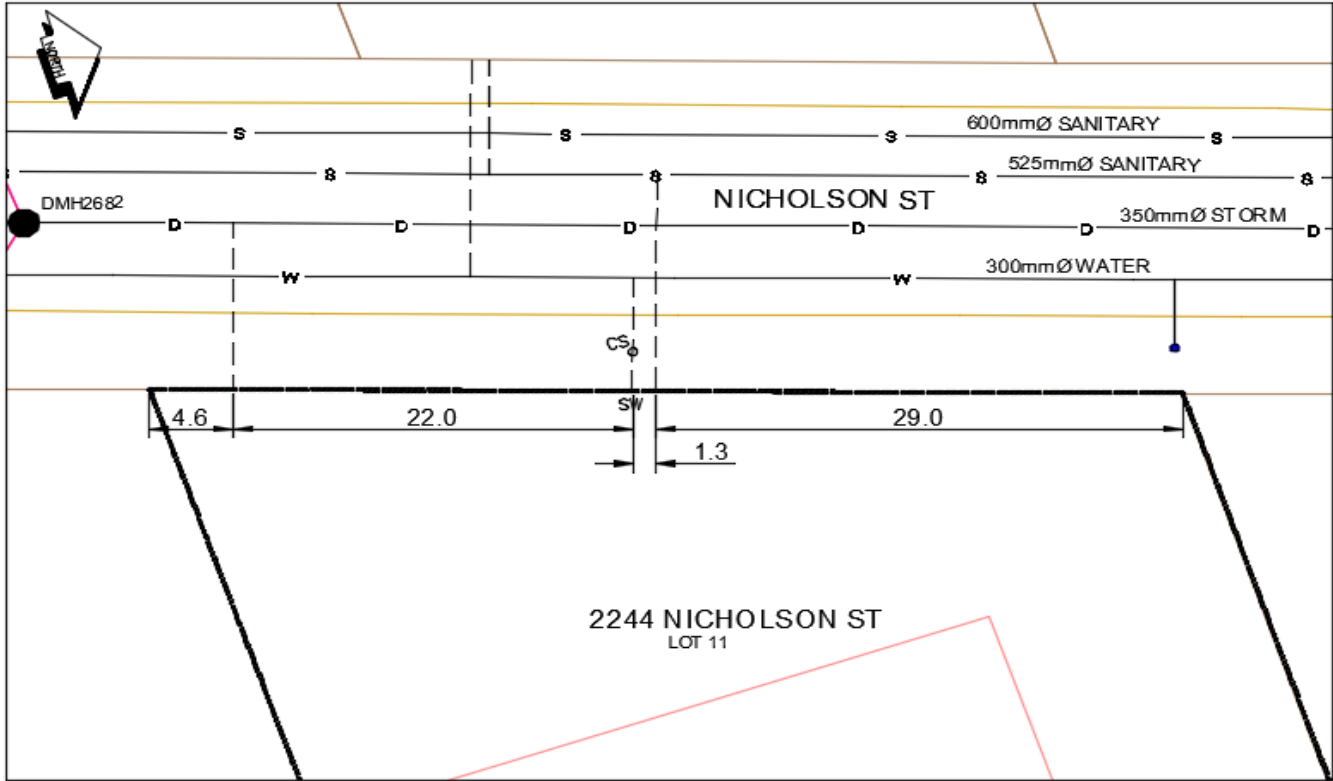

CS	CURB STOP	---	WATER SERVICE	---	STORM SERVICE
CO	CLEAN OUT	---	SANITARY SERVICE	---	GAS

**NOT TO SCALE**