

City of Prince George

HISTORY SHEET

SHEET NUMBER

PID # 004061691

Legal: LOT'S 24 BLOCK D.L. 777 PLAN 17401

Address: 2537 ABBOTT CRES.

Sanitary Connection: # 6421 SIZE 100 mm MATERIAL A.C. INV. 585,992 CONNECTED

Water Connection: # 6421 SIZE 20 mm MATERIAL CU. METER CONNECTED

Storm Connection: # SIZE mm MATERIAL INV. CONNECTED

Cash Receipt No's: WATER SANITARY STORM

CURB FROM PROPERTY LINE 4,877 m PAVEMENT WIDTH 10,363 m

B.C. HYDRO U/G UNDERGROUND CONNECTION



B.C. TELEPHONE U/G UNDERGROUND CONNECTION

INLAND GAS 3,048 m FROM R.L.

Information Sheets:

Comments:

**THE INFORMATION CONTAINED HEREIN IS FOR INTERNAL USE ONLY.
NOT TO BE RELIED UPON UNLESS CONFIRMED BY SITE INSPECTION AND/OR INVESTIGATION**

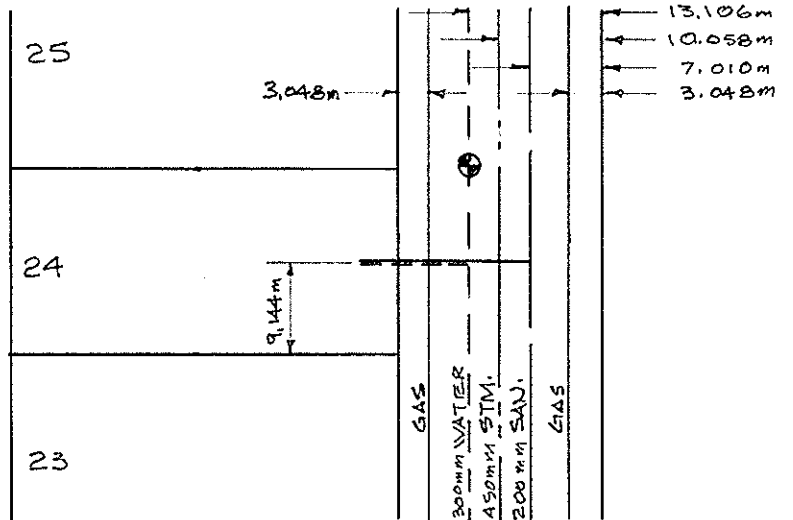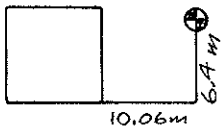

ABBOTT CRES.