

**City of Prince George  
HISTORY SHEET**

004065719K

SHEET NUMBER

Roll Number

Legal: LOT'S B BLOCK I D.L. 777 PLAN 24406

Address: 2224 TAMARACK ST.

Sanitary Connection: # 4975 SIZE 100mm MATERIAL A.C. INV. 568.880 CONNECTED

Water Connection # 4228 SIZE 20mm MATERIAL CU. METER CONNECTED

Storm Connection: # \_\_\_\_\_ SIZE \_\_\_\_\_ MATERIAL \_\_\_\_\_ INV. \_\_\_\_\_ CONNECTED

Cash Receipt No's: WATER \_\_\_\_\_ SANITARY \_\_\_\_\_ STORM \_\_\_\_\_

CURB FROM PROPERTY LINE 4.877m PAVEMENT WIDTH 10.363m

B.C. HYDRO O/H UNDERGROUND CONNECTION \_\_\_\_\_



B.C. TELEPHONE O/H UNDERGROUND CONNECTION \_\_\_\_\_

INLAND GAS 4.572m FROM WEST SIDE OF TAMARACK ST.

Information Sheets:

Comments: WITH THAW WIRE.

**THE INFORMATION CONTAINED HEREIN IS FOR INTERNAL USE ONLY.  
NOT TO BE RELIED UPON UNLESS CONFIRMED BY SITE INSPECTION AND/OR INVESTIGATION**

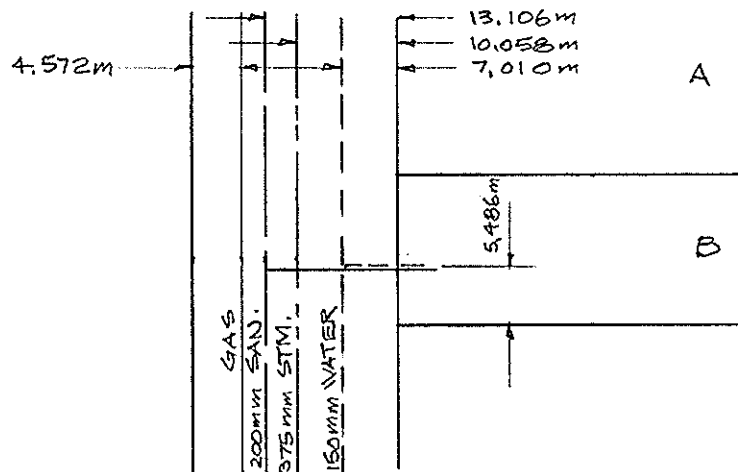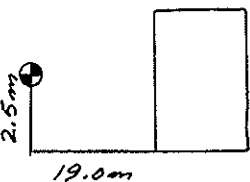

TAMARACK ST.

