

# City of Prince George

## HISTORY SHEET

SHEET NUMBER \_\_\_\_\_ PID # \_\_\_\_\_

Legal: LOT'S \_\_\_\_\_ BLOCK \_\_\_\_\_ D.L. 1427 PLAN PG512

Address: 4051 MCRAE AVE ; 199 N OSPIKA BLVD

Sanitary Connection: # \_\_\_\_\_ SIZE \_\_\_\_\_ mm MATERIAL \_\_\_\_\_ INV. \_\_\_\_\_ CONNECTED \_\_\_\_\_

Water Connection: # \_\_\_\_\_ SIZE \_\_\_\_\_ mm MATERIAL \_\_\_\_\_ METER \_\_\_\_\_ CONNECTED \_\_\_\_\_

Storm Connection: # \_\_\_\_\_ SIZE \_\_\_\_\_ mm MATERIAL \_\_\_\_\_ INV. \_\_\_\_\_ CONNECTED \_\_\_\_\_

Cash Receipt No's: WATER \_\_\_\_\_ SANITARY \_\_\_\_\_ STORM \_\_\_\_\_

CURB FROM PROPERTY LINE \_\_\_\_\_ PAVEMENT WIDTH \_\_\_\_\_

B.C. HYDRO \_\_\_\_\_ UNDERGROUND CONNECTION \_\_\_\_\_


B.C. TELEPHONE \_\_\_\_\_ UNDERGROUND CONNECTION \_\_\_\_\_

INLAND GAS \_\_\_\_\_

Information Sheets: \_\_\_\_\_

Comments: \_\_\_\_\_

**THE INFORMATION CONTAINED HEREIN IS FOR INTERNAL USE ONLY.  
NOT TO BE RELIED UPON UNLESS CONFIRMED BY SITE INSPECTION AND/OR INVESTIGATION**

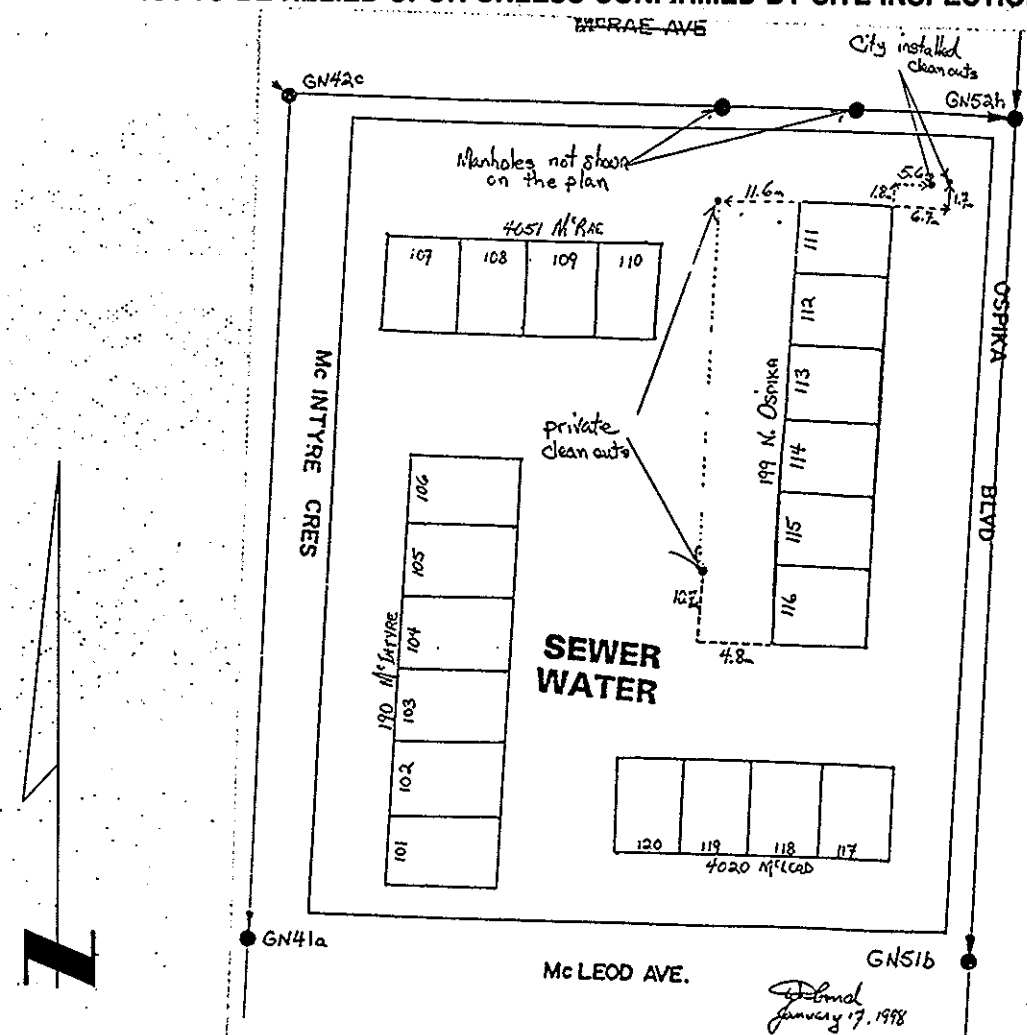

*Dr. J. J. ...*  
January 17, 1998