



City of Prince George  
**History Sheet**

PID:	004103602
	004103629
	004103637
	004103645
SD/MU:	
WO:	

Civic Address: 1888 3rd Ave

Legal Description: Lot: 38 to 51 Block: 48 District Lot: 343 Plan: 1268


Service Type	Diameter (mm)	Material	Invert Elev at main (m)	Invert Elev at property line (m)	Invert Elev at service end (m)	Distance into property (m)	Installation Date
Sanitary	100mm	AC	-	-	-	-	January 1957
Water	20mm	Copper	-	-	-	-	January 1957
Storm	N/A	N/A	-	-	-	-	

Service Connection Location	Sanitary (m)	Storm (m)
100mm Sanitary service connected to San MH1005	-	
Distance from downstream Stm MH - towards upstream Stm MH	-	

Power	Size	Communications	Size	Cable	Size	Gas	Size
BC Hydro	-	Telus	-	Shaw	-	FortisBC	-
Underground Service		Underground Service		Underground Service			

Installed by:	Survey Date:	-
Comments:		

**NOT TO SCALE** The information contained herein is for internal use only.  
Not to be relied on unless confirmed by site inspection and/or investigation.

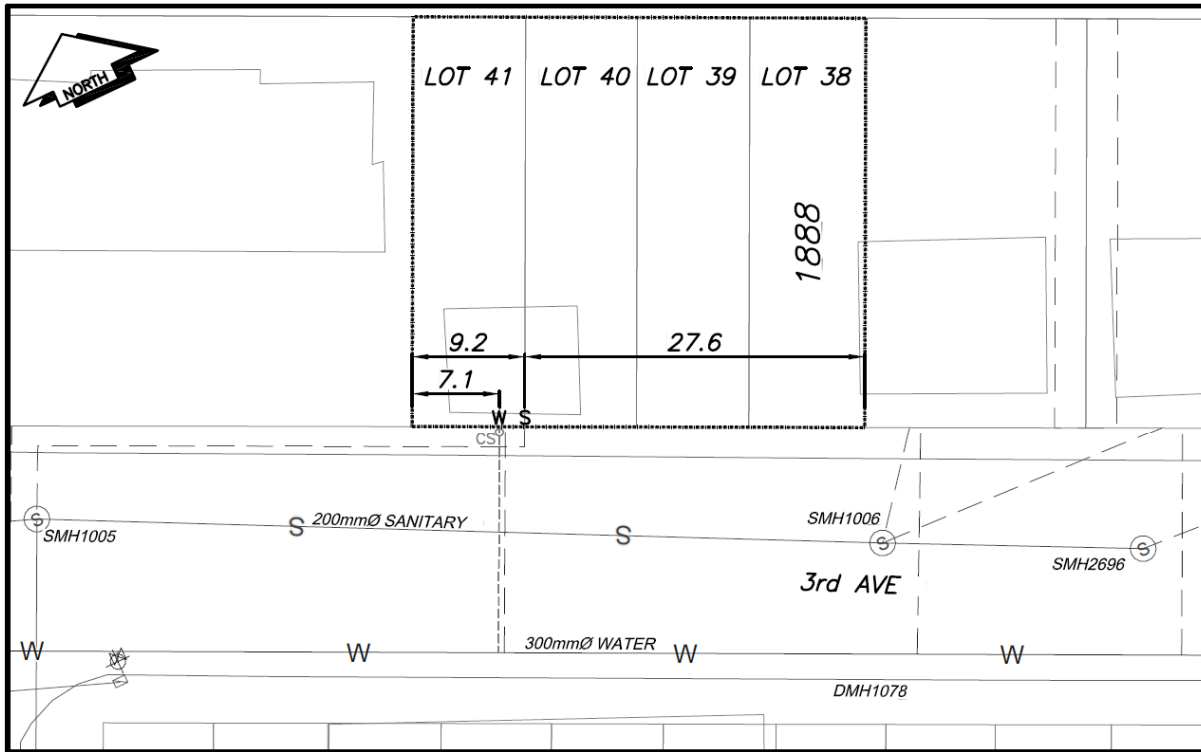

LEGEND:	Symbol	Description
CS	Circle with cross	CURB STOP
CO	Circle with dot	CLEAN OUT
W	Circle with X	WATER VALVE
— —	Line with arrow	WATER SERVICE
- - - —	Dashed line with arrow	SANITARY SERVICE
— —	Line with circle	STORM SERVICE
—G—	Line with G	GAS
- - - - -	Dashed line	ENCUMBRANCE
⊕	Circle with cross	FIRE HYDRANT

**NOT TO SCALE**