



CITY OF  
**PRINCE GEORGE**

Civic Address: 1888 3rd Ave

Legal Description: Lot: 38-41 Block: 48 District Lot: 343 Plan: 1268

**Lot Services Sketch**

PID:	004103645
	004103637
	004103629
	004103602



Service Type	Diameter (mm)	Material	Invert Elev @ Main (m)	Invert Elev @ Property Line (m)	Invert Elev @ Service End (m)	Distance into Property (m)	Installation Date
Sanitary	-	AC	-	-	-	-	1957
Water	25	PVC	579.20	-	-	14.5	2022
Storm	N/A	-	-	-	-	-	-

Sanitary Service Connection Location Notes	Storm Service Connection Location Notes
Distance from downstream SAN MH #: -	Distance from downstream STM MH #: N/A
Distance to upstream SAN MH #: -	Distance to upstream STM MH #: N/A

Miscellaneous Utilities			
Power	Communications	Cable	Gas
BC Hydro	TELUS	Shaw Cable	FortisBC
Overhead Service	Overhead Service	Overhead Service	Underground Service

Installation By:	WATER INSTALLED BY COPG 2022	Draft Date:	-	Survey Date:	-
Comments:					

**NOT TO SCALE** The information contained herein is for internal use only.  
Not to be relied on unless confirmed by site inspection and/or investigation.

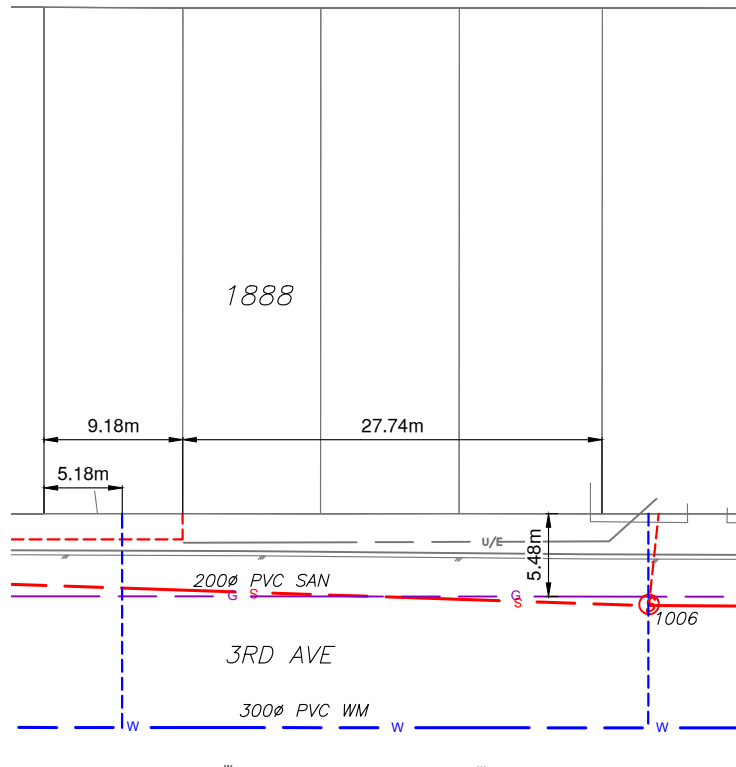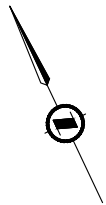

	WATER SERVICE AND CURB STOP (CS)		G	UNDERGROUND GAS LINE
	WATER HYDRANT LEAD, VALVE, HYDRANT		W	WATER MAIN
	SANITARY SERVICE AND CLEAN OUT (CO)		S	SANITARY MAIN
	STORM SERVICE		D	STORM MAIN
	ROAD EDGE			ENCUMBRANCE