

# City of Prince George HISTORY SHEET

SHEET NUMBER

Roll Number 004162-480

Legal: LOT'S 58 BLOCK — D.L. 2507 PLAN 16227

Address: 1134 CLUCULZ AVE

Sanitary Connection: # 5216 SIZE 100 mm MATERIAL A.C INV. 601.247 CONNECTED

Water Connection # 5216 SIZE 20 mm MATERIAL CU METER CONNECTED

Storm Connection: # \_\_\_\_\_ SIZE \_\_\_\_\_ MATERIAL \_\_\_\_\_ INV. \_\_\_\_\_ CONNECTED

Cash Receipt No's: WATER \_\_\_\_\_ SANITARY \_\_\_\_\_ STORM \_\_\_\_\_

CURB FROM PROPERTY LINE 4.877 m PAVEMENT WIDTH 10.363 m

B.C. HYDRO U/G UNDERGROUND CONNECTION



B.C. TELEPHONE U/G UNDERGROUND CONNECTION

INLAND GAS 3.657 m FROM RZ

Information Sheets:

Comments: WITH THAV WIRE

**THE INFORMATION CONTAINED HEREIN IS FOR INTERNAL USE ONLY.  
NOT TO BE RELIED UPON UNLESS CONFIRMED BY SITE INSPECTION AND/OR INVESTIGATION**

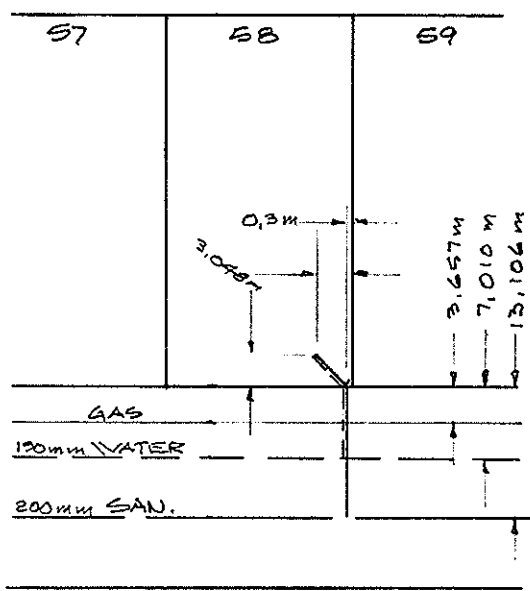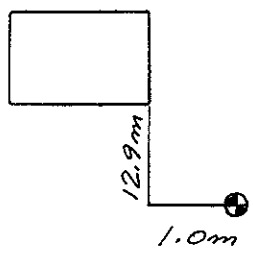

CLUCULZ AVE.

