

**City of Prince George  
HISTORY SHEET**

604195 795 S

SHEET NUMBER

11112

Roll Number

Legal: LOT'S

10 V2

BLOCK

D.L. 4040

PLAN 92.02

Address:

4244 FEHR RD.

Sanitary Connection: #

13207

SIZE 100mm $\phi$  MATERIAL

INV. 649.20m CONNECTED

Water Connection #

SIZE MATERIAL

METER CONNECTED

Storm Connection: #

SIZE MATERIAL

INV. CONNECTED

Cash Receipt No's:

WATER

SANITARY

1881

STORM

# 1882

CURB FROM PROPERTY LINE

PAVEMENT WIDTH

B.C. HYDRO

UNDERGROUND CONNECTION

B.C. TELEPHONE


UNDERGROUND CONNECTION

INLAND GAS

Information Sheets:

Comments:

N/O WATER SERVICE: ON FEHR RD - S.P. IS 6" HIGH.

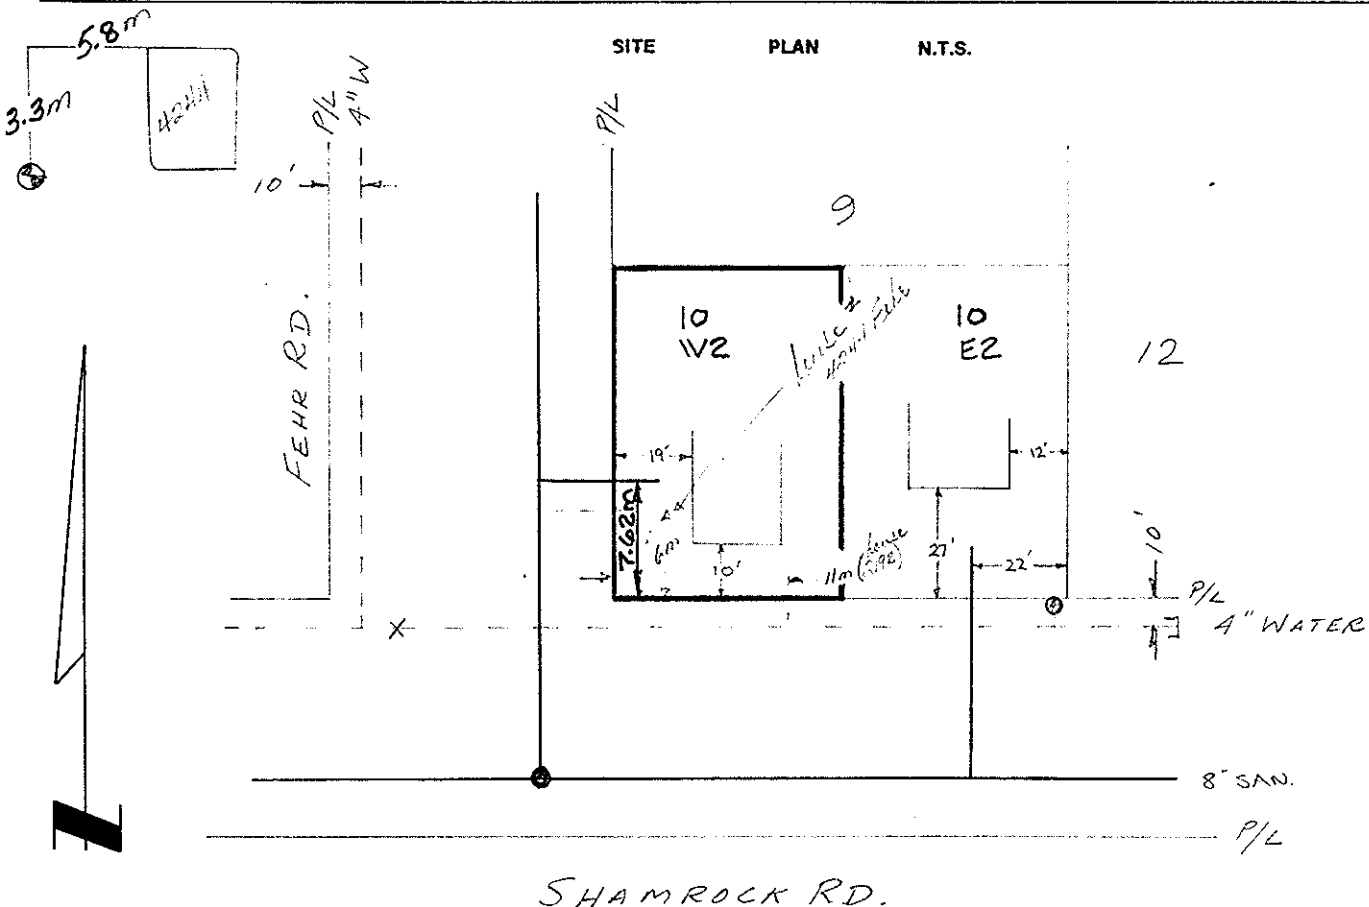

79.64