
## City of Prince George HISTORY SHEET

004220749

SHEET NUMBER	11476	Roll Number					
Legal: LOT'S	1	BLOCK	D.L.	2.101	PLAN	19733	
Address:	343/	ROSIA RD.					
Sanitary Connection:	#	SIZE	MATERIAL	INV.		CONNECTED	
Water Connection #		SIZE	MATERIAL	METER		CONNECTED	
Storm Connection:		SIZE	MATERIAL	INV.		CONNECTED	
Cash Receipt No's:	WATER		SANITARY		STORM		
CURB FROM PROPERTY LI	NE			PAVEMENT WIDTH			
B.C. HYDRO			UNDERGROUND CON	INECTION			
B.C. TELEPHONE		UNDERGROUND CONNECTION					
INLAND GAS							
Information Sheets:							
Comments:							

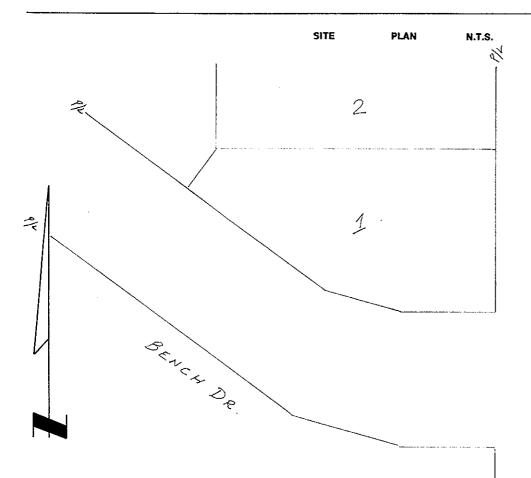

ROSIA RD.