

City of Prince George HISTORY SHEET

SHEET NUMBER

Roll Number 004223154

Legal: LOT'S 56 BLOCK _____ D.L. 938 PLAN 13549

Address: 336 NORTH OGILVIE STREET

Sanitary Connection: # 3587 SIZE _____ MATERIAL _____ INV. _____ CONNECTED _____

Water Connection: # 3587 SIZE 20mm MATERIAL COPPER METER _____ CONNECTED _____

Storm Connection: # _____ SIZE _____ MATERIAL _____ INV. _____ CONNECTED _____

Cash Receipt No's: WATER _____ SANITARY _____ STORM _____

CURB FROM PROPERTY LINE _____ PAVEMENT WIDTH _____

B.C. HYDRO _____ UNDERGROUND CONNECTION _____

B.C. TELEPHONE _____ UNDERGROUND CONNECTION _____


INLAND GAS _____

Information Sheets: _____

Comments: _____

THE INFORMATION CONTAINED HEREIN IS FOR INTERNAL
USE ONLY. NOT TO BE RELIED UPON UNLESS CONFIRMED
BY SITE INSPECTION AND/OR INVESTIGATION.

SITE PLAN N.T.S.

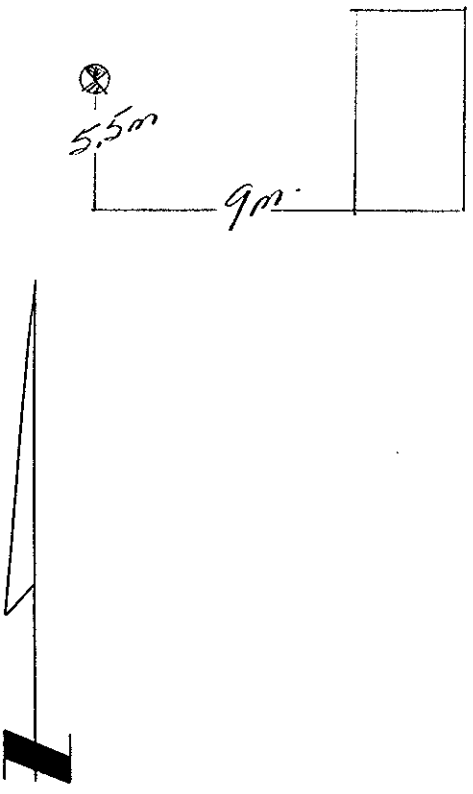

OGILVIE ST.

