

City of Prince George HISTORY SHEET

001237956

SHEET NUMBER **Nº 1098** Roll Number **972**

Legal: LOT'S **21-22** BLOCK **37** D.L. **1429** PLAN **646**

Address: **978 IRWIN ST.**

Sanitary Connection: # **3071** SIZE MATERIAL INV. CONNECTED

Water Connection # **1597** SIZE **13mm** MATERIAL METER CONNECTED

Storm Connection: # SIZE MATERIAL INV. CONNECTED

Cash Receipt No's: WATER SANITARY **6.17** STORM

CURB FROM PROPERTY LINE PAVEMENT WIDTH


B.C. HYDRO UNDERGROUND CONNECTION

B.C. TELEPHONE UNDERGROUND CONNECTION

INLAND GAS

Information Sheets:

Comments:

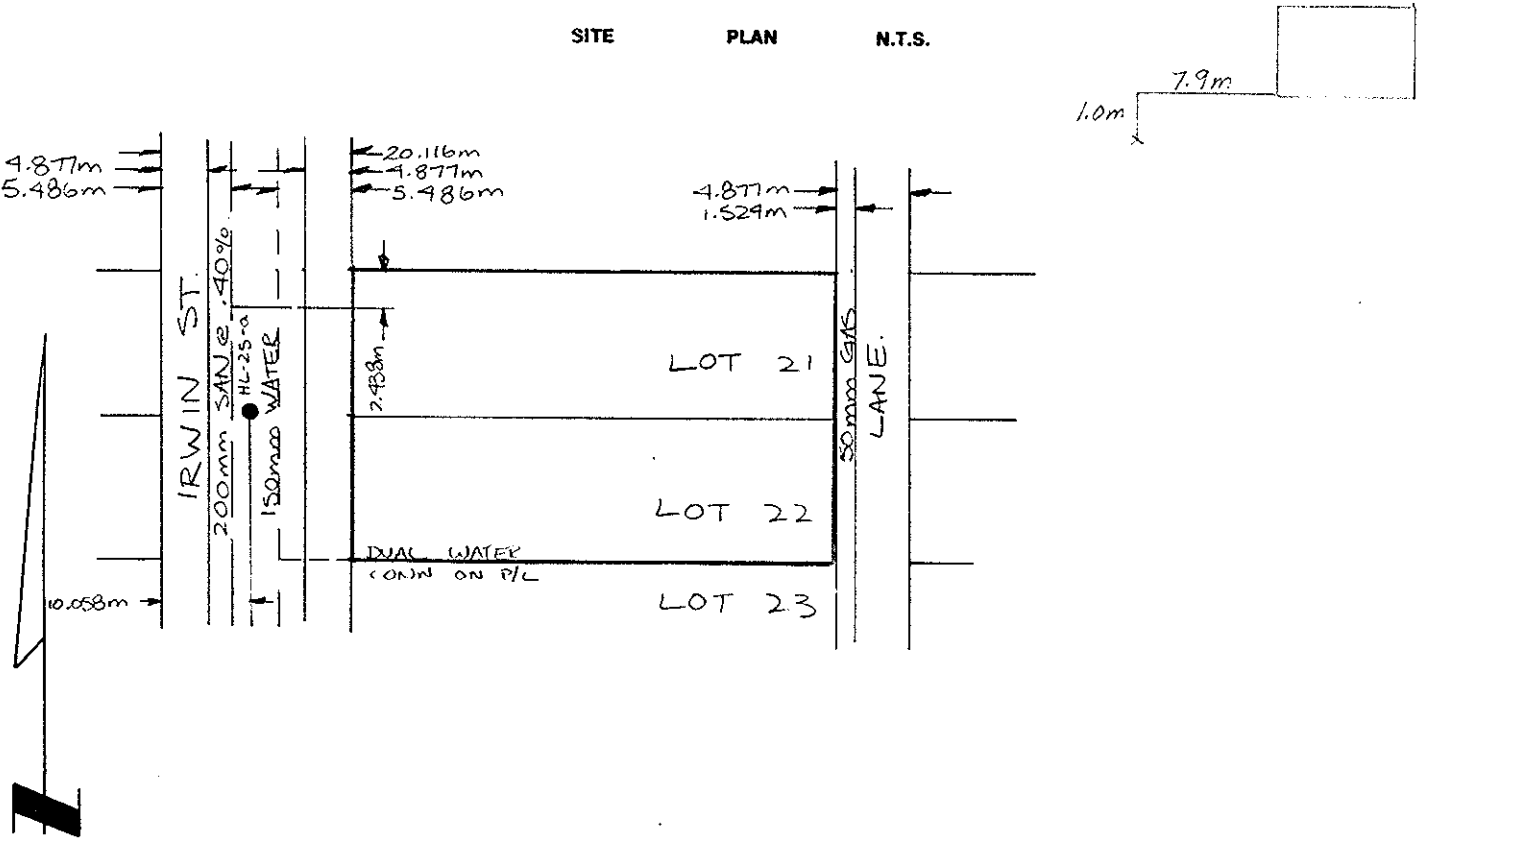

REPORT TO RECORDS

WATER SERVICE INFORMATION

Lot No. _____ Block _____ D.L. _____


Address 978 Irwin

Size of Connection 1/2" 3/4" Other _____

Type of Connection Copper Iron

Thaw Wire Yes No

LOCATION SKETCH

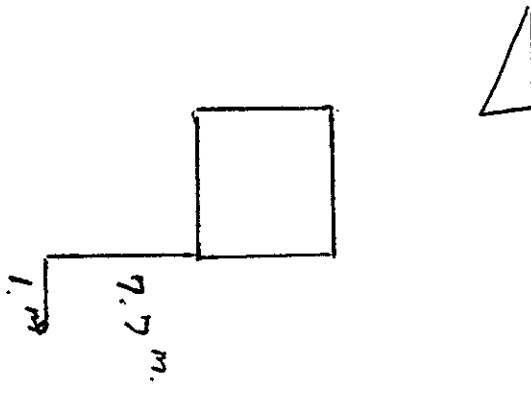

Field Location By G.C. Date 6/8/92

Checked by: _____