

**City of Prince George
HISTORY SHEET**

004-259-114

SHEET NUMBER

Roll Number

Legal: LOT'S 3 BLOCK _____ D.L. 2610 PLAN 16510

Address: 118 TRADER CRES

Sanitary Connection: # 5573 SIZE 100 mm MATERIAL A.C. INV. 601.174 CONNECTED

Water Connection # 5573 SIZE 200mm MATERIAL Cu. METER _____ CONNECTED

Storm Connection: # _____ SIZE _____ MATERIAL _____ INV. _____ CONNECTED

Cash Receipt No's: WATER _____ SANITARY _____ STORM _____

CURB FROM PROPERTY LINE 4.377 m PAVEMENT WIDTH 10.363 m


B.C. HYDRO U/G UNDERGROUND CONNECTION

B.C. TELEPHONE U/G UNDERGROUND CONNECTION


INLAND GAS 3.048 m FROM R

Information Sheets:

Comments:

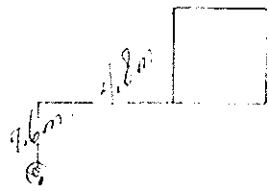

SITE PLAN N.T.S.

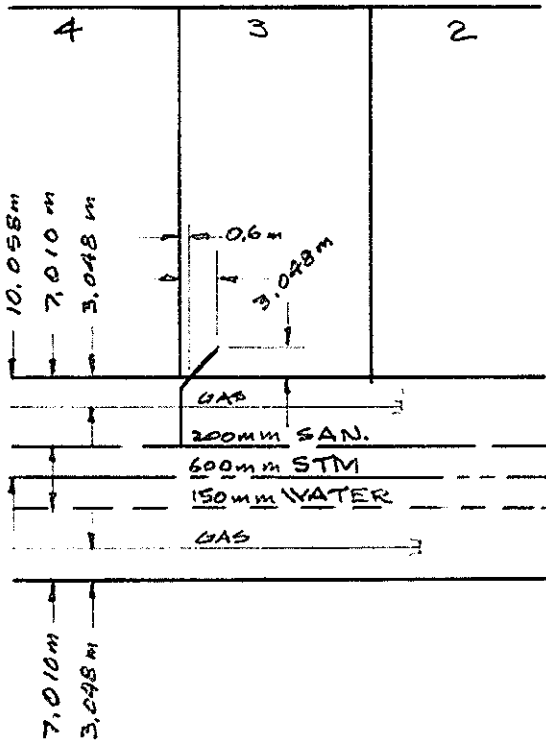

TRADER
CRES

