

City of Prince George

HISTORY SHEET

SHEET NUMBER

PID # 004-290-607

Legal: LOTS 20 BLOCK 4 D.L. 8178 PLAN 17368

Address: 320 BEECH CRES.

Sanitary Connection: # SIZE 100 mm MATERIAL A.C. INV. CONNECTED ✓

Water Connection: # 7100 SIZE 20 mm MATERIAL C.U. METER CONNECTED ✓

Storm Connection: # SIZE mm MATERIAL INV. CONNECTED

Cash Receipt No's: WATER SANITARY STORM

CURB FROM PROPERTY LINE 4.572 m PAVEMENT WIDTH 9.144 m

B.C. HYDRO U/G UNDERGROUND CONNECTION



B.C. TELEPHONE U/G UNDERGROUND CONNECTION

INLAND GAS

Information Sheets:

Comments: WITH THAW WIRE.

**THE INFORMATION CONTAINED HEREIN IS FOR INTERNAL USE ONLY.
NOT TO BE RELIED UPON UNLESS CONFIRMED BY SITE INSPECTION AND/OR INVESTIGATION**

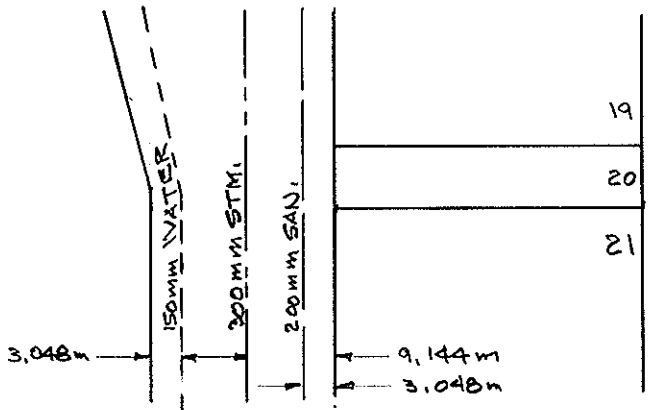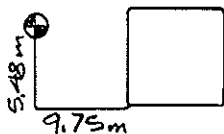

BEECH CRES.

