

# City of Prince George HISTORY SHEET

004293657-  
Roll Number 004293614-1

SHEET NUMBER \_\_\_\_\_ Roll Number \_\_\_\_\_

Legal: LOT'S 9-10 BLOCK 111 D.L. 958 PLAN 752

Address: 183 KELLY ST.

Sanitary Connection: # 3370 SIZE \_\_\_\_\_ MATERIAL \_\_\_\_\_ INV. \_\_\_\_\_ CONNECTED \_\_\_\_\_

Water Connection # 3364 SIZE 3/4" MATERIAL Cu METER \_\_\_\_\_ CONNECTED \_\_\_\_\_

Storm Connection: # \_\_\_\_\_ SIZE \_\_\_\_\_ MATERIAL \_\_\_\_\_ INV. \_\_\_\_\_ CONNECTED \_\_\_\_\_

Cash Receipt No's: WATER \_\_\_\_\_ SANITARY \_\_\_\_\_ STORM \_\_\_\_\_

CURB FROM PROPERTY LINE \_\_\_\_\_ PAVEMENT WIDTH \_\_\_\_\_


B.C. HYDRO \_\_\_\_\_ UNDERGROUND CONNECTION \_\_\_\_\_

B.C. TELEPHONE \_\_\_\_\_ UNDERGROUND CONNECTION \_\_\_\_\_

INLAND GAS \_\_\_\_\_

Information Sheets: \_\_\_\_\_

Comments: \_\_\_\_\_

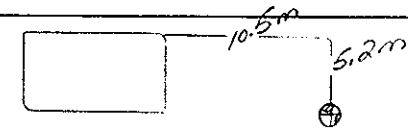

SITE PLAN N.T.S.

