



City of Prince George
History Sheet

PID:	004307127
SD/MU:	
WO:	

Civic Address: 2929 Ferry Ave

Legal Description: Lot: B District Lot: 1433 Plan: 10380


Service Type	Diameter (mm)	Material	Invert Elev at main (m)	Invert Elev at property line (m)	Invert Elev at service end (m)	Distance into property (m)	Installation Date
Sanitary	100mm	PVC	-	-	-	-	April 1988
Water	N/A	N/A	-	-	-	-	-
Storm	N/A	N/A	-	-	-	-	-

Service Connection Location	Sanitary (m)	Storm (m)
100mm Sanitary service connected to San MH 4978	-	
Distance from downstream Stm MH - towards upstream Stm MH -		

Power	Size	Communications	Size	Cable	Size	Gas	Size
BC Hydro	-	Telus	-	Shaw	-	FortisBC	-
Overhead Service		Overhead Service		Overhead Service			

Installed by:	Survey Date:	-
Comments: Water for this property us provided by an onsite private well.		

NOT TO SCALE The information contained herein is for internal use only.
Not to be relied on unless confirmed by site inspection and/or investigation.

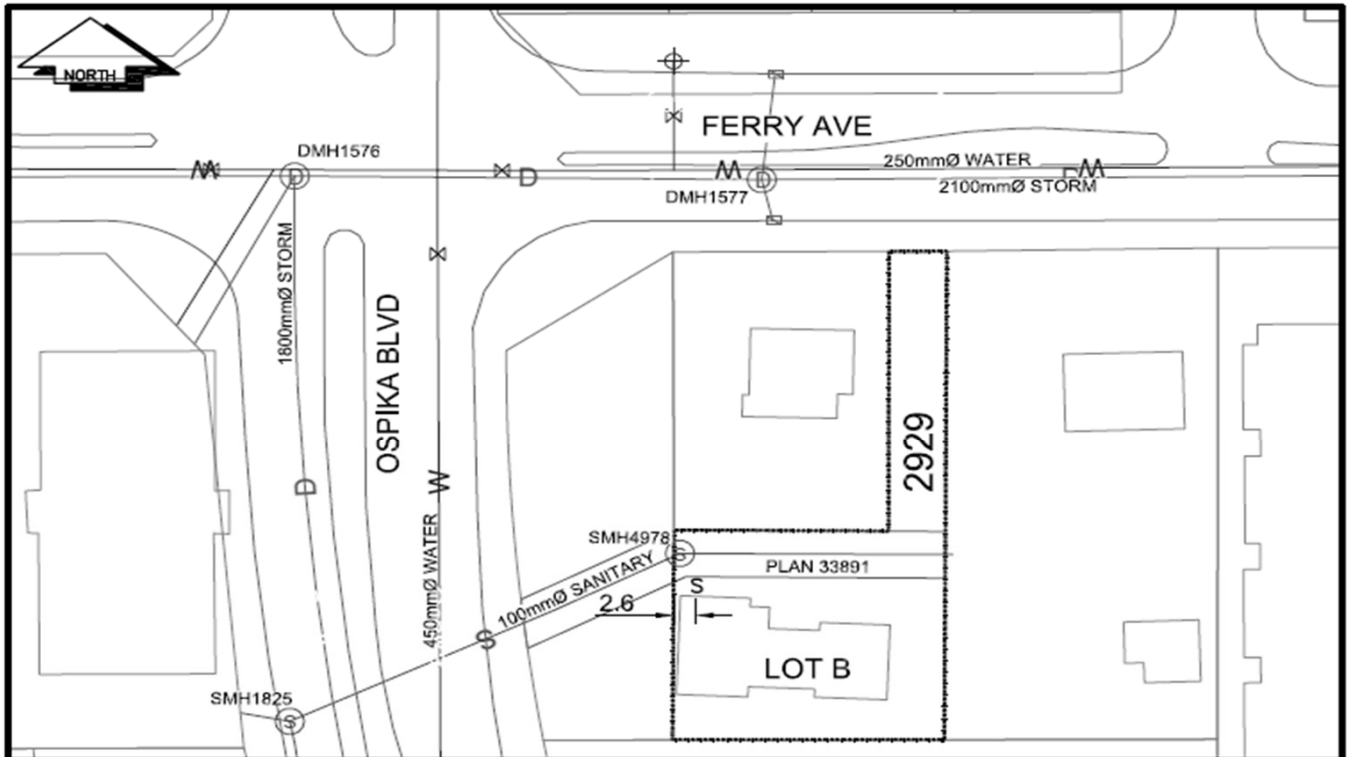

LEGEND:	
CS	CURB STOP
CO	CLEAN OUT
⊗	WATER VALVE
—W—	WATER SERVICE
- - - S - - -	SANITARY SERVICE
⊗	FIRE HYDRANT
—S—	STORM SERVICE
—G—	GAS
- - - - -	ENCUMBRANCE

NOT TO SCALE