



City of Prince George  
**History Sheet**

PID:	004331711
SD/MU:	
WO:	

Civic Address: 1720 Norwood St

Legal Description: Lot: 17 - 18 Block: 265 District Lot: 343 Plan: 1268


Service Type	Diameter (mm)	Material	Invert Elev at main (m)	Invert Elev at property line (m)	Invert Elev at service end (m)	Distance into property (m)	Installation Date
Sanitary	100mm	PVC	-	-	-	-	-
Water	20mm	Copper	-	-	-	-	-
Storm	N/A	N/A	-	-	-	-	-

Service Connection Location				Sanitary (m)	Storm (m)
Distance from downstream San MH	3191	towards upstream San MH	3186	87.00	
Distance from downstream Stm MH	-	towards upstream Stm MH	-		

Power	Size	Communications	Size	Cable	Size	Gas	Size
BC Hydro	-	Telus	-	Shaw	-	FortisBC	-
Overhead Service		Overhead Service		Overhead Service			

Installed by:		Survey Date:	-
Comments:	City forces confirmed sanitary service connection location February 20, 2013		

**NOT TO SCALE The information contained herein is for internal use only.  
Not to be relied on unless confirmed by site inspection and/or investigation.**

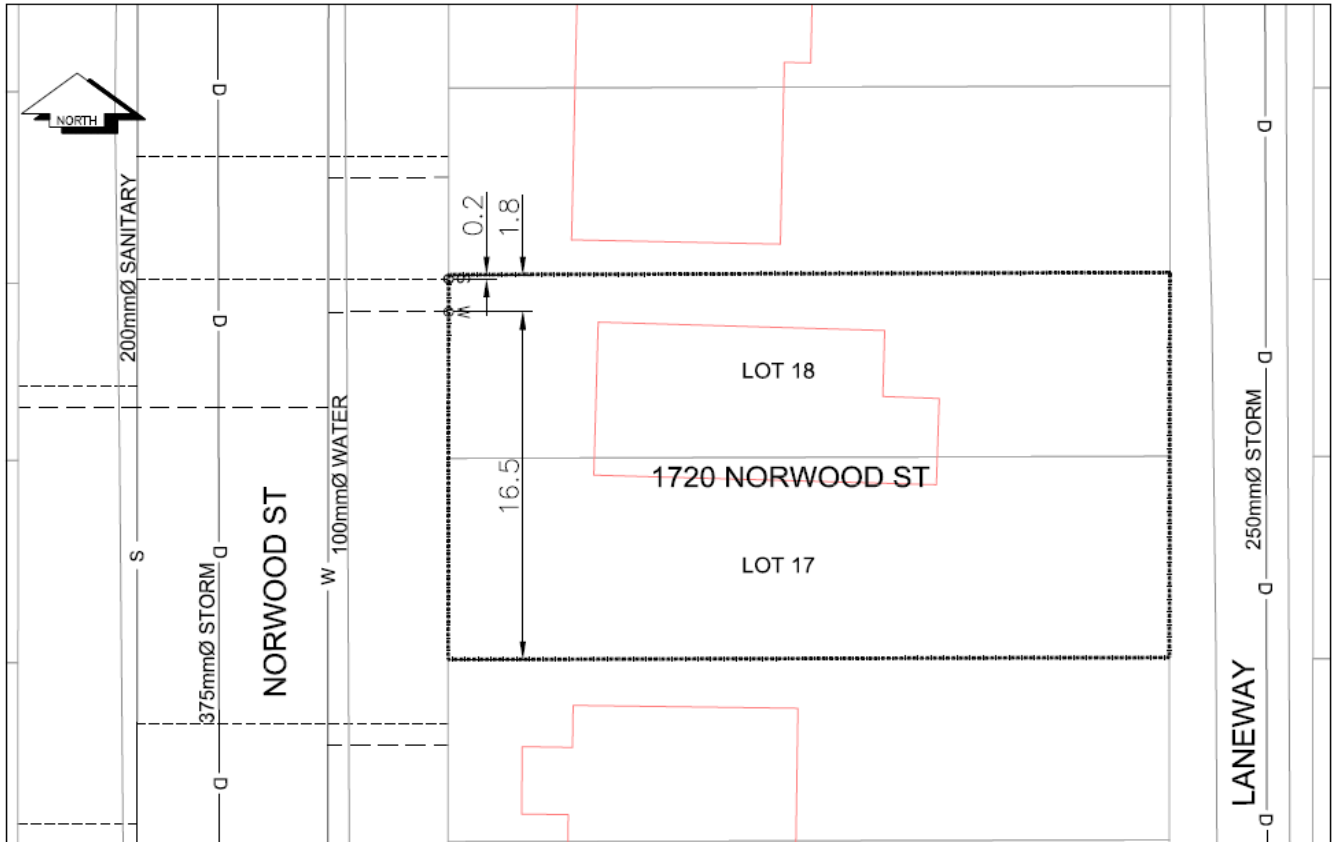

LEGEND:

CS <sup>o</sup>	CURB STOP	---	W	WATER SERVICE	---	o	STORM SERVICE
CO <sup>o</sup>	CLEAN OUT	---	S	SANITARY SERVICE	---	X	WATER VALVE

**NOT TO SCALE**