

City of Prince George HISTORY SHEET

SHEET NUMBER

PID # 004338006

Legal: LOTS 42 BLOCK D.L. 8175 PLAN 16074

Address: 2766 FAIRVIEW CRES.

Sanitary Connection: # 5946 SIZE 100 mm MATERIAL A.C. INV. 587.686 CONNECTED

Water Connection: # 5946 SIZE 20 mm MATERIAL CU METER CONNECTED

Storm Connection: # SIZE mm MATERIAL INV. CONNECTED

Cash Receipt No's: WATER SANITARY STORM

CURB FROM PROPERTY LINE 3.962 m PAVEMENT WIDTH 10.363 m

B.C. HYDRO U/G UNDERGROUND CONNECTION



B.C. TELEPHONE U/G UNDERGROUND CONNECTION

INLAND GAS 3.352 m FROM R IN LANE.

Information Sheets:

Comments: WITH THAW WIRE.

**THE INFORMATION CONTAINED HEREIN IS FOR INTERNAL USE ONLY.
NOT TO BE RELIED UPON UNLESS CONFIRMED BY SITE INSPECTION AND/OR INVESTIGATION**

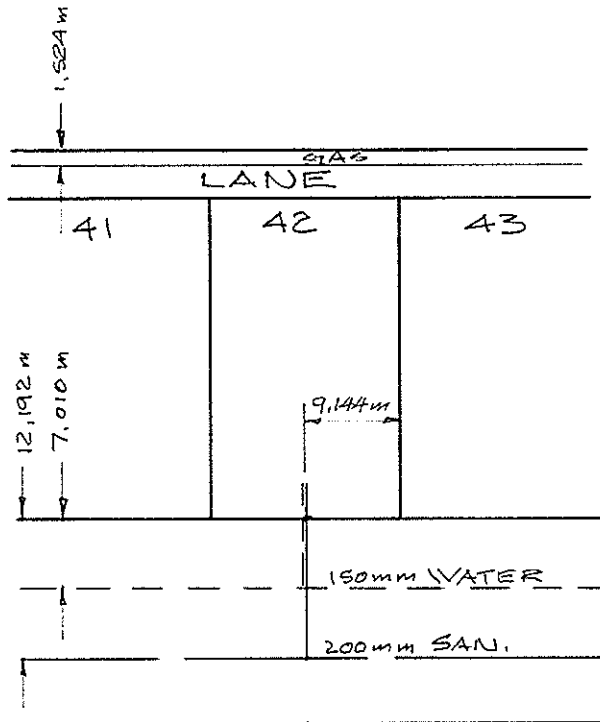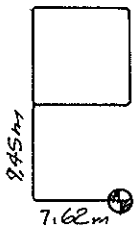

FAIRVIEW
CRES.