

City of Prince George HISTORY SHEET

SHEET NUMBER

Roll Number **004339380**

Legal: LOT'S **3** BLOCK D.L. **8171-8172** PLAN **19517**

Address: **3532 DUFFERIN AVE.**

Sanitary Connection: # **7436** SIZE **100mm** MATERIAL **A/C** INV. CONNECTED

Water Connection # **7436** SIZE **20mm** MATERIAL **CU** METER CONNECTED

Storm Connection: # SIZE MATERIAL INV. CONNECTED

Cash Receipt No's: WATER SANITARY STORM

CURB FROM PROPERTY LINE **4.877m** PAVEMENT WIDTH **10.363m**

B.C. HYDRO **U/G** UNDERGROUND CONNECTION



B.C. TELEPHONE **U/G** UNDERGROUND CONNECTION

INLAND GAS **AS SHOWN**

Information Sheets:

Comments: **WITH THAW WIRE**

**THE INFORMATION CONTAINED HEREIN IS FOR INTERNAL USE ONLY.
NOT TO BE RELIED UPON UNLESS CONFIRMED BY SITE INSPECTION AND/OR INVESTIGATION**

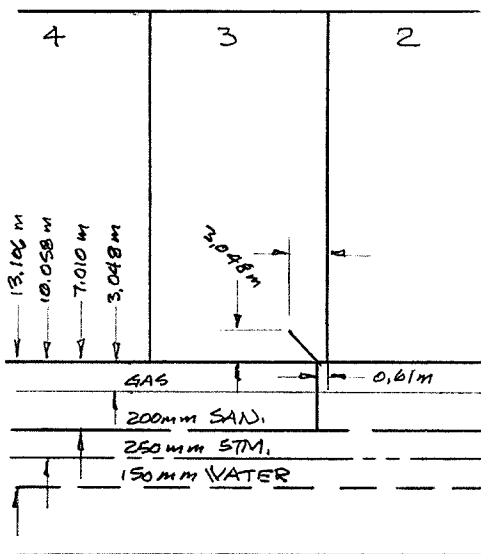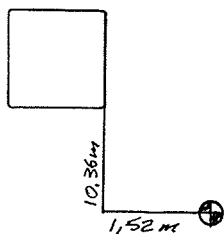

DUFFERIN AVE.

