



City of Prince George  
**History Sheet**

PID:	004341147
SD/MU:	
WO:	

Civic Address: 7636 Moncton Cres  
Legal Description: Lot: 6 District Lot: 754 Plan: 22200


Service Type	Diameter (mm)	Material	Invert Elev at main (m)	Invert Elev at property line (m)	Invert Elev at service end (m)	Distance into property (m)	Installation Date
Sanitary	100mm	AC	-	-	-	-	December 1975
Water	20mm	Copper	-	-	-	-	December 1975
Storm	N/A	N/A	-	-	-	-	

Service Connection Location				Sanitary (m)	Storm (m)
Distance from downstream San MH	4484	towards upstream San MH	4417	114.21	
Distance from downstream Stm MH	-	towards upstream Stm MH	-		

Power	Size	Communications	Size	Cable	Size	Gas	Size
BC Hydro	-	Telus	-	Shaw	-	FortisBC	-
Underground Service		Underground Service		Underground Service			

Installed by:		Survey Date:	-
Comments:	Water service location confirmed June 27, 2018.		

**NOT TO SCALE** The information contained herein is for internal use only.  
Not to be relied on unless confirmed by site inspection and/or investigation.

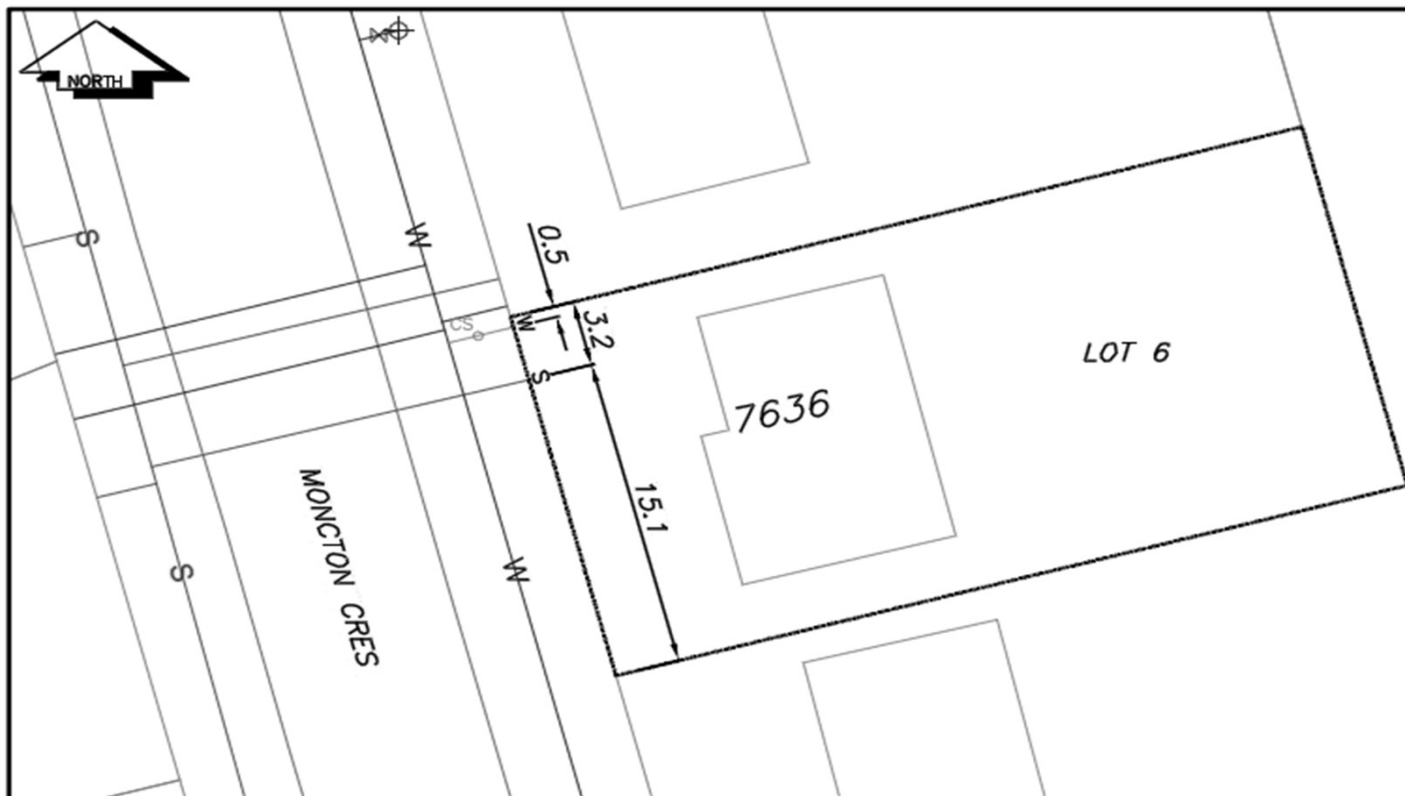

LEGEND:					
CS	CURB STOP	W	WATER SERVICE	Ø	STORM SERVICE
CO	CLEAN OUT	S	SANITARY SERVICE	G	GAS
⊗	WATER VALVE	⊗	FIRE HYDRANT	- - -	ENCUMBRANCE

**NOT TO SCALE**