


City of Prince George HISTORY SHEET

SHEET NUMBER		Roll Number 004351983			
Legal:	LOT'S 35	BLOCK	D.L. 2608	PLAN	19520
Address: 204 CLARK CRES					
Sanitary Connection:	# 7327	SIZE 100MM	MATERIAL	INV.	CONNECTED
Water Connection	# 7327	SIZE 20MM	MATERIAL Copper	METER	CONNECTED
Storm Connection:	#	SIZE	MATERIAL	INV.	CONNECTED
Cash Receipt No's:	WATER	SANITARY	STORM		
CURB FROM PROPERTY LINE			PAVEMENT WIDTH		
B.C. HYDRO		UNDERGROUND CONNECTION			
B.C. TELEPHONE		UNDERGROUND CONNECTION			
INLAND GAS					
Information Sheets:					
Comments:					

**THE INFORMATION CONTAINED HEREIN IS FOR INTERNAL USE ONLY.
NOT TO BE RELIED UPON UNLESS CONFIRMED BY SITE INSPECTION AND/OR INVESTIGATION**

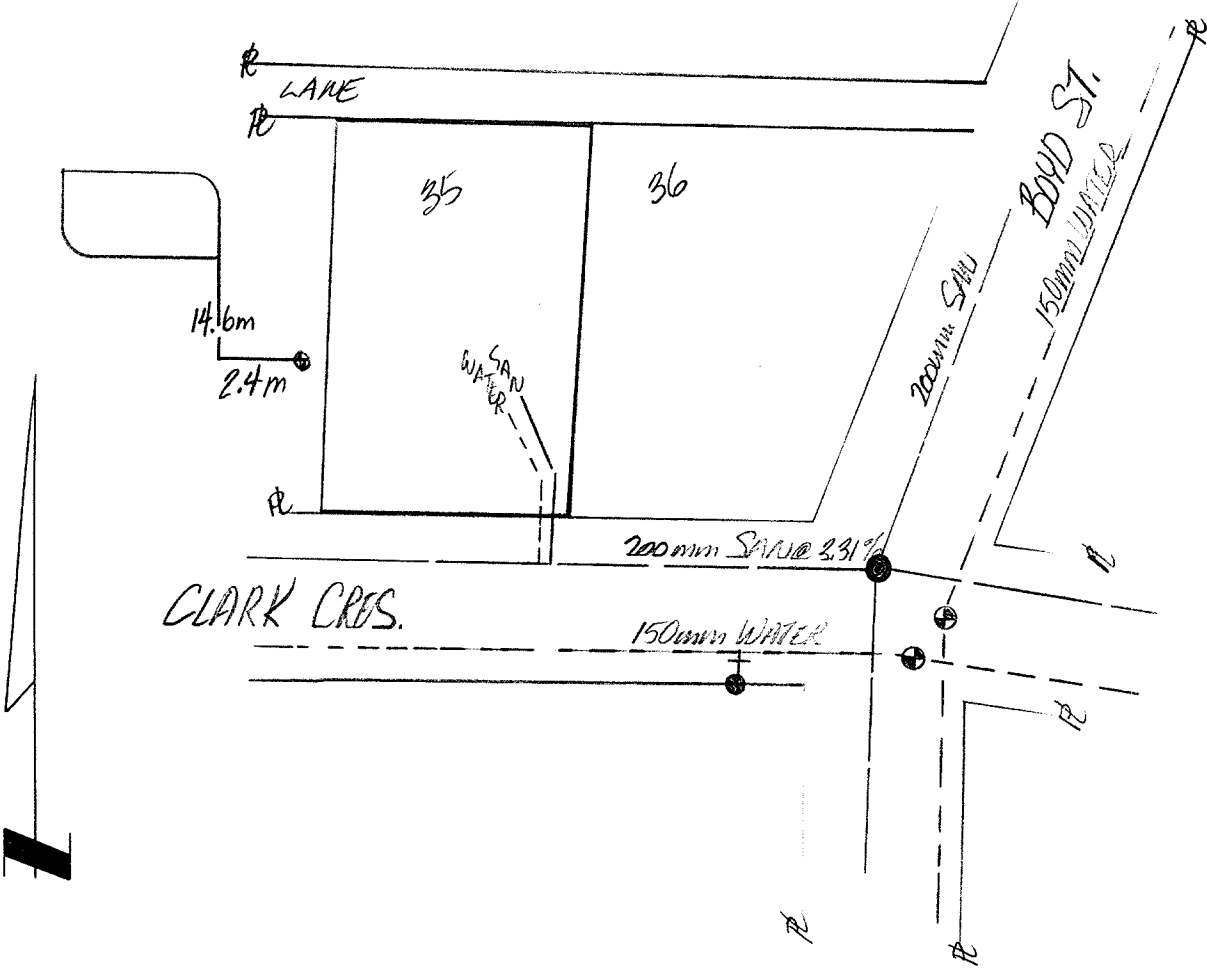

REPORT TO RECORDS

WATER SERVICE INFORMATION

Lot No. _____ Block _____ D.L. _____


 Address 204 CLARK CRES

 Size of Connection 1/2" 3/4" Other _____

 Type of Connection Copper Iron

 Thaw Wire Yes No

LOCATION SKETCH

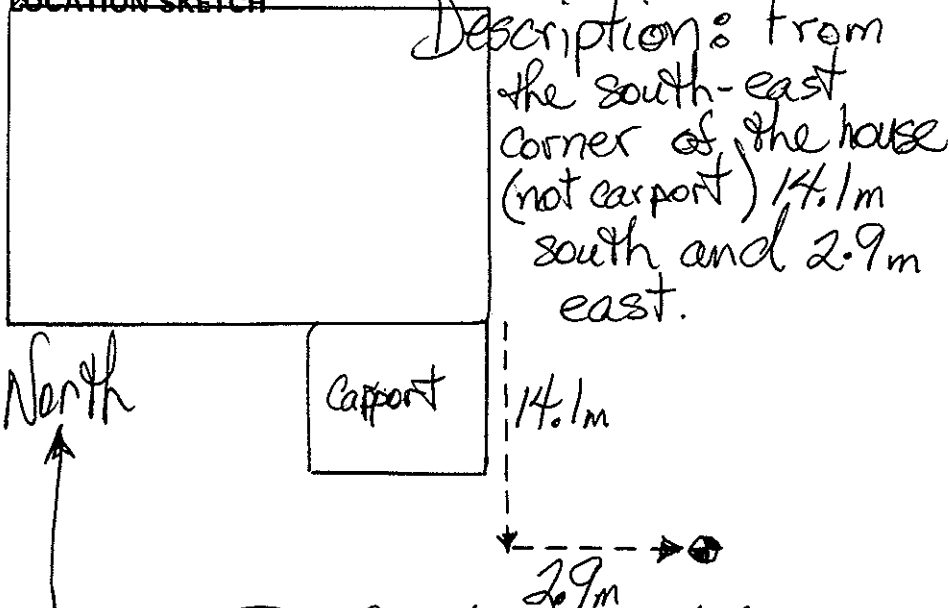
 Field Location By W Bond Date July 4, 2001

Checked by: _____

REPORT TO RECORDS

SEWER SERVICE INFORMATION

Lot No. _____ Block _____ D.L. _____


Address 204 CHARK CRES

Size of Connection 100mm 150mm 200mm Other _____

Type of Connection Transite PVC Other _____

Type of Cap Transite Cast Iron

LOCATION SKETCH

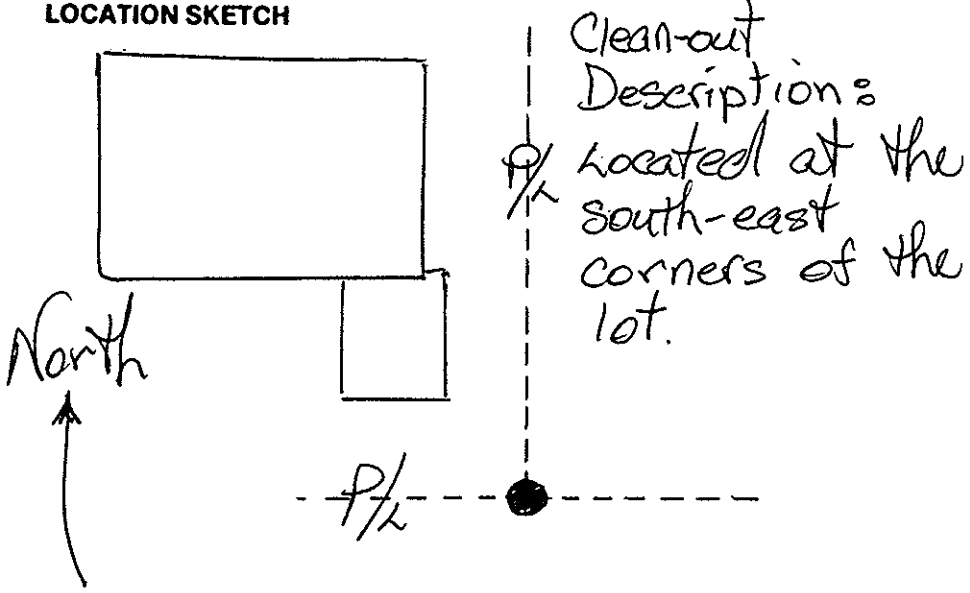

Field Location By [Signature] Date July 4, 2001

Checked by Foreman - Sewer Division _____