
City of Prince George HISTORY SHEET

Roll Number 004352084 Legal: LOT'S 12 BLOCK D.L. 8175 PLAN 18054						
Legal: LOT'S 12	BLOCK			D.L. 8175	plan 18054	
Address: 2812 WILLINGDON PLACE						
Sanitary Connection: # 6398	SIZE	·	MATERIAL	INV.	CONNECTED	
Water Connection # 6398	SIZE	20MM	MATERIAL	METER	CONNECTED	
Storm Connection: #	SIZE		MATERIAL	INV.	CONNECTED	
Cash Receipt No's: WATER		SANITARY			STORM	
CURB FROM PROPERTY LINE	PAVEMENT WIDTH					
B.C. HYDRO	UNDERGROUND CONNECTION					
B.C. TELEPHONE	UNDERGROUND CONNECTION					
INLAND GAS						
Information Sheets:						
Comments:						

THE INFORMATION CONTAINED HEREIN IS FOR INTERNAL USE ONLY. NOT TO BE RELIED UPON UNLESS CONFIRMED BY SITE INSPECTION AND/OR INVESTIGATION

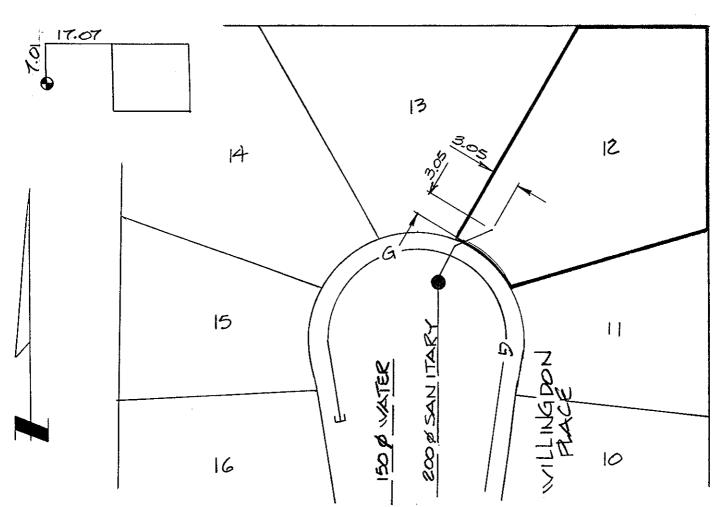

WESTWOOD DR.