



City of Prince George
History Sheet

PID:	004352149
	004352165
	004352173
SD/MU:	
WO:	

Civic Address: 1989 Ross Cres

Legal Description: Lot: 19 - 21 Block: 124 District Lot: 343 Plan: 1268


Service Type	Diameter (mm)	Material	Invert Elev at main (m)	Invert Elev at property line (m)	Invert Elev at service end (m)	Distance into property (m)	Installation Date
Sanitary	100mm	AC	-	579.37	1.92	-	December 1956
Water	20mm	Copper	-	-	-	-	December 1961
Storm	N/A	N/A	-	-	-	-	

Service Connection Location				Sanitary (m)	Storm (m)
Distance from downstream San MH	2693	towards upstream San MH	2690	-	
Distance from downstream Stm MH	-	towards upstream Stm MH	-		

Power	Size	Communications	Size	Cable	Size	Gas	Size
BC Hydro	-	Telus	-	Shaw	-	FortisBC	-
Overhead Service		Overhead Service		Overhead Service			

Installed by:	Survey Date:	-
Comments:		

NOT TO SCALE The information contained herein is for internal use only.
Not to be relied on unless confirmed by site inspection and/or investigation.

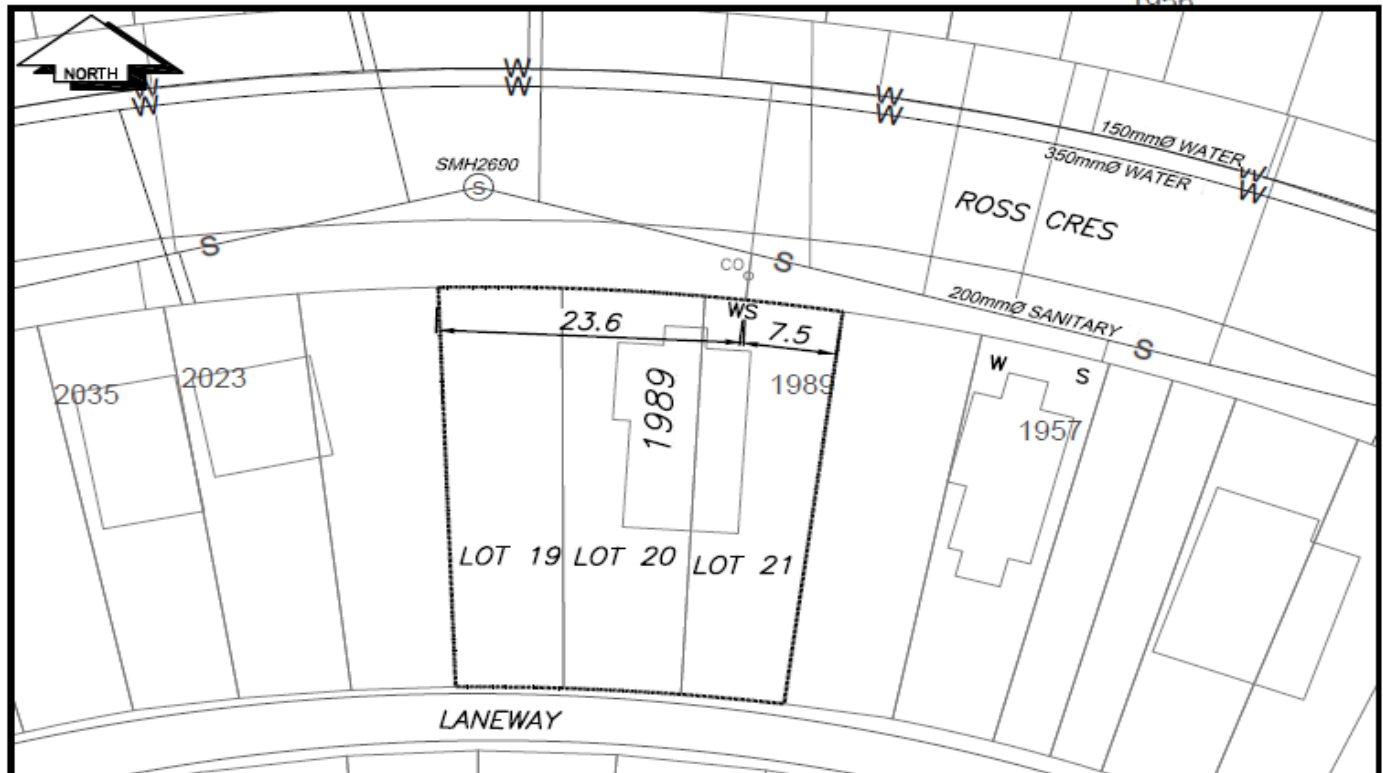

LEGEND:		
CS ^o	CURB STOP	—W— WATER SERVICE
CO ^o	CLEAN OUT	- - - - S SANITARY SERVICE
⊗	WATER VALVE	—G— GAS
		—S— STORM SERVICE
		—X— FIRE HYDRANT
		- - - - ENCUMBRANCE

NOT TO SCALE