

City of Prince George HISTORY SHEET

1451

Roll Number

SHEET NUMBER

Legal: LOT'S 10-11-12 BLOCK 168 D.L. 343 PLAN 1268

Address: 829 5th AVENUE

Sanitary Connection: # 1941 SIZE 3/4" MATERIAL COPPER COPPER INV. 1861.72 CONNECTED YES

Water Connection # 10192 SIZE 4" MATERIAL CAST METER CONNECTED YES

Storm Connection: # 156 554 SIZE 4" MATERIAL A.C. INV. 56.16 CONNECTED YES

Cash Receipt No's: WATER SANITARY STORM

CURB FROM PROPERTY LINE 19 PAVEMENT WIDTH 42'

B.C. HYDRO O.H. UNDERGROUND CONNECTION


B.C. TELEPHONE O.H. UNDERGROUND CONNECTION

INLAND GAS ALONG 5th AVENUE 1/2" MAIN

Information Sheets:

Comments: BENCH MARK # 302-70 ELEVATION = 1866.21
TOP OF BOLT BASE OF SOFT STRAY CAR WASH

S.W. CORNER **THE INFORMATION CONTAINED HEREIN IS FOR INTERNAL USE ONLY. NOT TO BE RELIED UPON UNLESS CONFIRMED BY SITE INSPECTION AND/OR INVESTIGATION.** LEVEL BOOK # 303

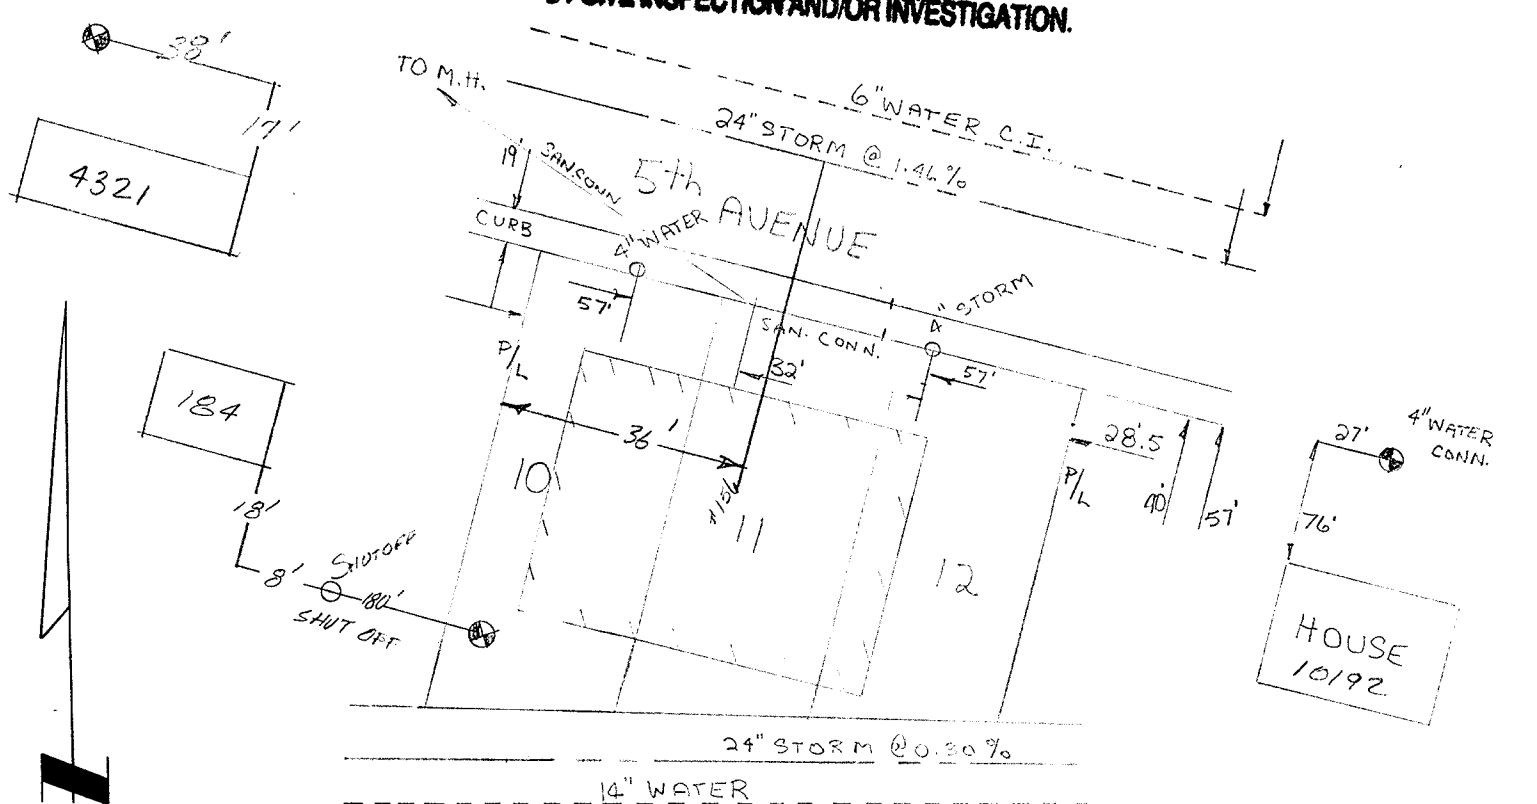

PATRICIA BLVD.