

City of Prince George HISTORY SHEET

SHEET NUMBER

Roll Number 004356730

Legal: LOT'S 78 BLOCK — D.L. 2507 PLAN 16227

Address: 1262 BEDNESTI CRES

Sanitary Connection: # 5236 SIZE 100mm MATERIAL A.C. INV. 603.012 CONNECTED

Water Connection # 5236 SIZE 20mm MATERIAL CU. METER CONNECTED

Storm Connection: # _____ SIZE _____ MATERIAL _____ INV. _____ CONNECTED

Cash Receipt No's: WATER _____ SANITARY _____ STORM _____

CURB FROM PROPERTY LINE 4.877m PAVEMENT WIDTH 10.363m

B.C. HYDRO U/G UNDERGROUND CONNECTION



B.C. TELEPHONE U/G UNDERGROUND CONNECTION

INLAND GAS 3.657m FROM SOUTH SIDE OF BEDNESTI CRES.

Information Sheets:

Comments: WITH THAW WIRE.

**THE INFORMATION CONTAINED HEREIN IS FOR INTERNAL USE ONLY.
NOT TO BE RELIED UPON UNLESS CONFIRMED BY SITE INSPECTION AND/OR INVESTIGATION**

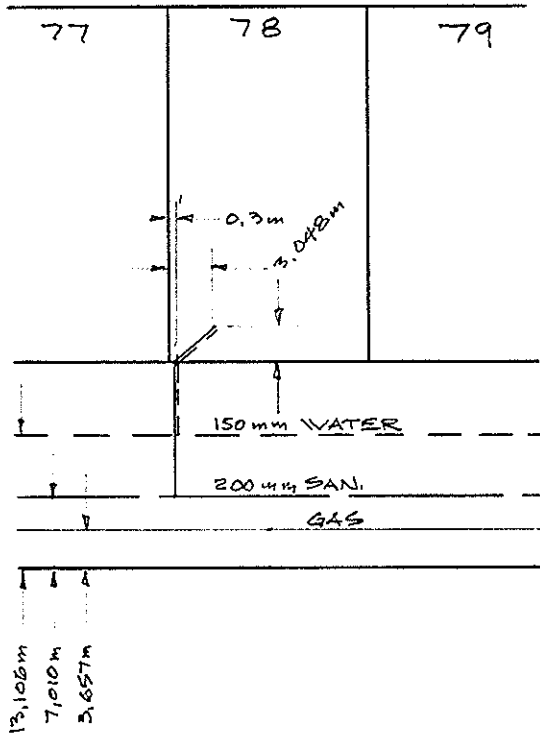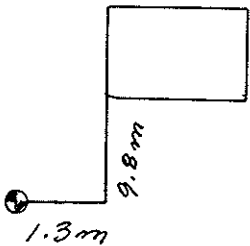

BEDNESTI
CRES.

