

# City of Prince George HISTORY SHEET

3542110  
917

SHEET NUMBER

Roll Number

Legal: LOT'S 35 & 36      BLOCK 7      D.L. 932      PLAN 796

Address: 2173-2175 OAK STREET

Sanitary Connection: # 6982      SIZE 100 mm MATERIAL A.C.      INV. 567.902      CONNECTED

Water Connection # 6982      SIZE 20 mm MATERIAL C.U.      METER      CONNECTED

Storm Connection: #      SIZE      MATERIAL      INV.      CONNECTED

Cash Receipt No's:      WATER      SANITARY      STORM

CURB FROM PROPERTY LINE 4.877 m      PAVEMENT WIDTH 10.363 m

B.C. HYDRO O/H      UNDERGROUND CONNECTION



B.C. TELEPHONE O/H      UNDERGROUND CONNECTION

INLAND GAS 3.657 m FROM R.

Information Sheets:

Comments: WITH THAW WIRE.

SITE      PLAN      N.T.S.

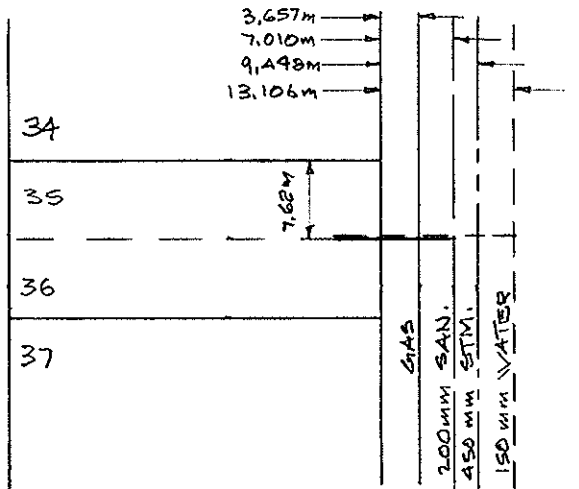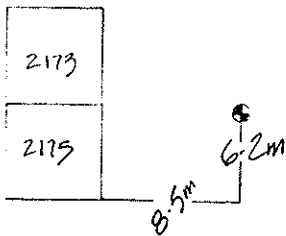

OAK ST.

