

354210
117

City of Prince George HISTORY SHEET

SHEET NUMBER

Roll Number

Legal: LOT'S 35 & 36 BLOCK 7 D.L. 932 PLAN 796

Address: 2173-2175 OAK STREET

Sanitary Connection: # 6982 SIZE 100 mm MATERIAL A.C. INV. 567.902 CONNECTED

Water Connection # 6982 SIZE 20 mm MATERIAL C.U. METER CONNECTED

Storm Connection: # SIZE MATERIAL INV. CONNECTED

Cash Receipt No's: WATER SANITARY STORM

CURB FROM PROPERTY LINE 4.877 m PAVEMENT WIDTH 10.363 m

B.C. HYDRO O/H UNDERGROUND CONNECTION



B.C. TELEPHONE O/H UNDERGROUND CONNECTION

INLAND GAS 3.657 m FROM R.

Information Sheets:

Comments: WITH THAW WIRE.

SITE PLAN N.T.S.

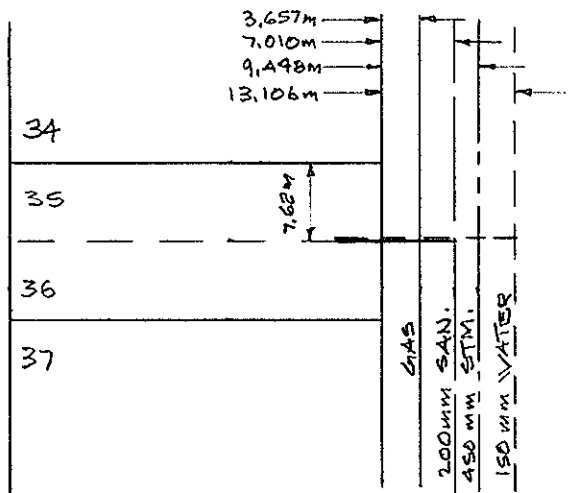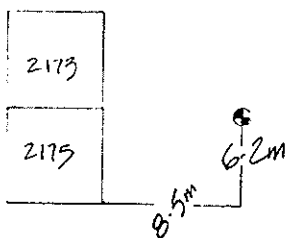

OAK ST.

