

City of Prince George HISTORY SHEET

SHEET NUMBER

Roll Number **004362063**

Legal: LOT'S 19 BLOCK _____ D.L. 711 PLAN 17101

Address: 2613 ABBOTT CRSS.

Sanitary Connection: # 6416 SIZE 100mm MATERIAL AC INV. _____ CONNECTED _____

Water Connection # 6416 SIZE _____ MATERIAL _____ METER _____ CONNECTED _____

Storm Connection: # _____ SIZE _____ MATERIAL _____ INV. _____ CONNECTED _____

Cash Receipt No's: WATER _____ SANITARY _____ STORM _____

CURB FROM PROPERTY LINE _____ PAVEMENT WIDTH _____

B.C. HYDRO _____ UNDERGROUND CONNECTION _____



B.C. TELEPHONE _____ UNDERGROUND CONNECTION _____

INLAND GAS _____

Information Sheets: _____

Comments: _____

**THE INFORMATION CONTAINED HEREIN IS FOR INTERNAL USE ONLY.
NOT TO BE RELIED UPON UNLESS CONFIRMED BY SITE INSPECTION AND/OR INVESTIGATION**

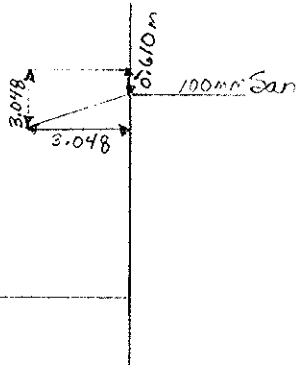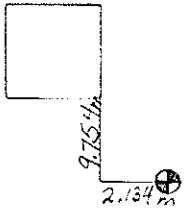

Lot 19

