

**City of Prince George
HISTORY SHEET**

JUN 20 10
471

SHEET NUMBER

Roll Number

Legal: LOT'S 33 & 34 BLOCK 7 D.L. 932 PLAN 796

Address: 2163 - 2165 OAK STREET

Sanitary Connection: # 6980 SIZE 100mm MATERIAL A.C. INV. 567.643 CONNECTED

Water Connection # 6980 SIZE 20mm MATERIAL C.U. METER CONNECTED

Storm Connection: # SIZE MATERIAL INV. CONNECTED

Cash Receipt No's: WATER SANITARY STORM

CURB FROM PROPERTY LINE 4.877m PAVEMENT WIDTH 10.363m

B.C. HYDRO O/H UNDERGROUND CONNECTION



B.C. TELEPHONE O/H UNDERGROUND CONNECTION

INLAND GAS 3.657m FROM R.

Information Sheets:

Comments: WITH THAW WIRE

SITE PLAN N.T.S.

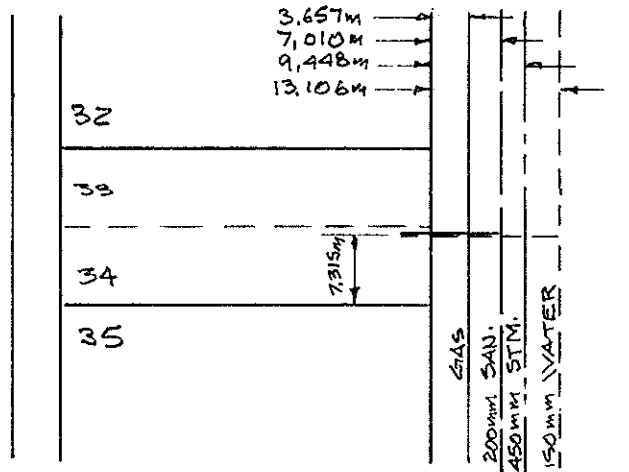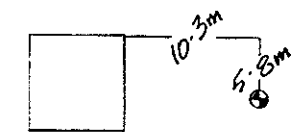

OAK ST.