

**City of Prince George  
HISTORY SHEET**

JUN 20 10  
471

SHEET NUMBER

Roll Number

Legal: LOT'S 33 & 34      BLOCK 7      D.L. 932      PLAN 796

Address: 2163 - 2165 OAK STREET

Sanitary Connection: # 6980      SIZE 100mm MATERIAL A.C.      INV. 567.643      CONNECTED

Water Connection # 6980      SIZE 20mm MATERIAL C.U.      METER      CONNECTED

Storm Connection: #      SIZE      MATERIAL      INV.      CONNECTED

Cash Receipt No's:      WATER      SANITARY      STORM

CURB FROM PROPERTY LINE 4.877m      PAVEMENT WIDTH 10.363m

B.C. HYDRO 0/H      UNDERGROUND CONNECTION



B.C. TELEPHONE 0/H      UNDERGROUND CONNECTION

INLAND GAS 3.657m FROM R.

Information Sheets:

Comments: WITH THAW WIRE

SITE      PLAN      N.T.S.

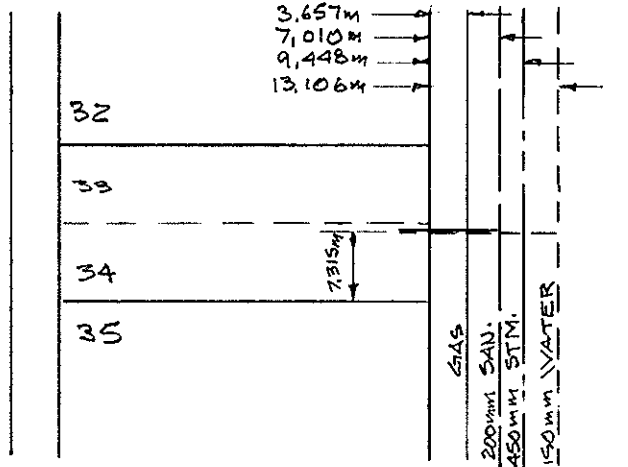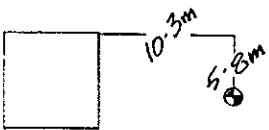

OAK ST.

