

**City of Prince George
HISTORY SHEET**

004370571

SHEET NUMBER

PID #

Legal: LOTS 34 BLOCK 9 D.L. 932 PLAN 796

Address: 2265 QUINCE ST.

Sanitary Connection: # 9159 SIZE 100 mm MATERIAL A.C. INV. 566.427 CONNECTED

Water Connection: # 9159 SIZE 20 mm MATERIAL CU. METER CONNECTED

Storm Connection: # SIZE mm MATERIAL INV. CONNECTED

Cash Receipt No's: WATER SANITARY 611 STORM

CURB FROM PROPERTY LINE 4.877 m PAVEMENT WIDTH 10.363 m

B.C. HYDRO O/H UNDERGROUND CONNECTION



B.C. TELEPHONE O/H UNDERGROUND CONNECTION

INLAND GAS 3.657 m FROM FL.

Information Sheets:

Comments: WITH THAW WIRE.

**THE INFORMATION CONTAINED HEREIN IS FOR INTERNAL USE ONLY.
NOT TO BE RELIED UPON UNLESS CONFIRMED BY SITE INSPECTION AND/OR INVESTIGATION**

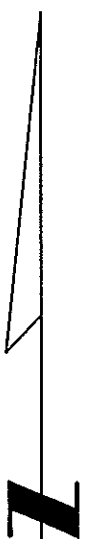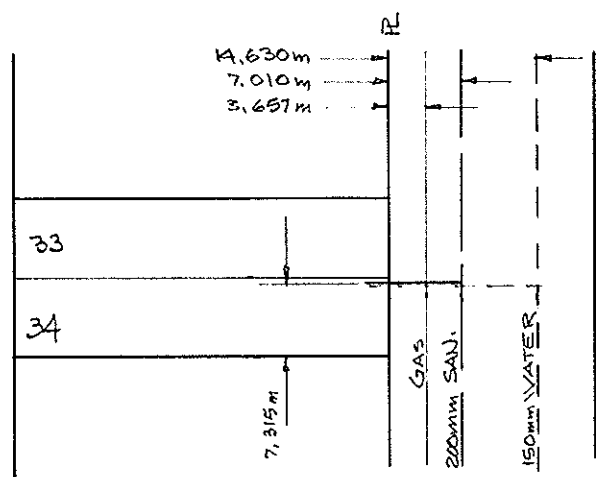

QUINCE ST.