

**City of Prince George
HISTORY SHEET**

004 377214

SHEET NUMBER

Roll Number

Legal: LOT'S 194 BLOCK D.L. 482 PLAN 20916

Address: 635 PILOT ST.

Sanitary Connection: # 8680 SIZE 100 mm MATERIAL A.C. INV. CONNECTED

Water Connection # 8680 SIZE 20 mm MATERIAL C.U. METER CONNECTED

Storm Connection: # SIZE MATERIAL INV. CONNECTED

Cash Receipt No's: WATER SANITARY STORM

CURB FROM PROPERTY LINE 4.877m PAVEMENT WIDTH 10.363m

B.C. HYDRO U/G UNDERGROUND CONNECTION



B.C. TELEPHONE U/G UNDERGROUND CONNECTION

INLAND GAS AS SHOWN

Information Sheets:

Comments:

**THE INFORMATION CONTAINED HEREIN IS FOR INTERNAL USE ONLY.
NOT TO BE RELIED UPON UNLESS CONFIRMED BY SITE INSPECTION AND/OR INVESTIGATION**

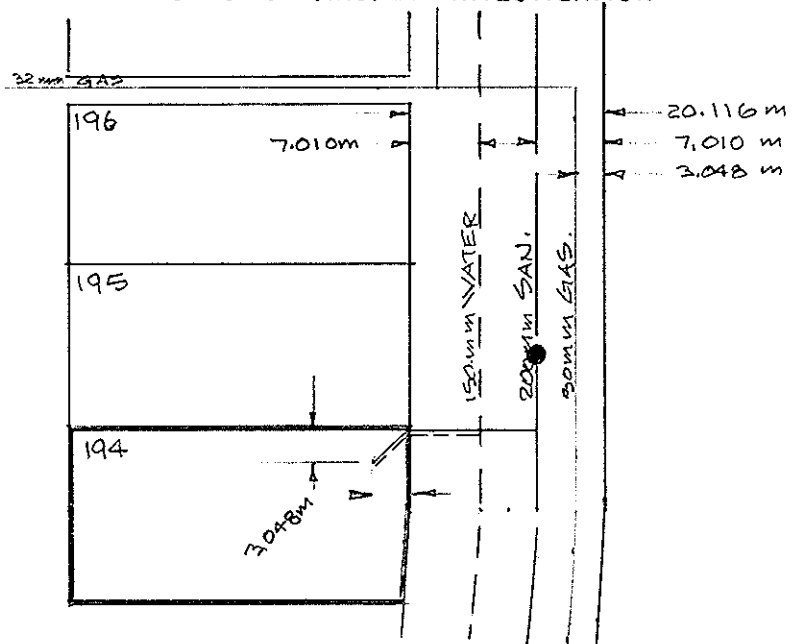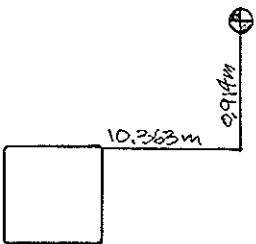

PILOT ST.