

# City of Prince George HISTORY SHEET

SHEET NUMBER

Roll Number 00438395

Legal: LOT'S 98 BLOCK \_\_\_\_\_ D.L. 958 PLAN 13198

Address: 250 NORTH OGILVIE STREET

Sanitary Connection: # 3582 SIZE \_\_\_\_\_ MATERIAL \_\_\_\_\_ INV. \_\_\_\_\_ CONNECTED \_\_\_\_\_

Water Connection # 3582 SIZE 20mm MATERIAL COPPER METER CONNECTED \_\_\_\_\_

Storm Connection: # \_\_\_\_\_ SIZE \_\_\_\_\_ MATERIAL \_\_\_\_\_ INV. \_\_\_\_\_ CONNECTED \_\_\_\_\_

Cash Receipt No's: WATER \_\_\_\_\_ SANITARY \_\_\_\_\_ STORM \_\_\_\_\_

CURB FROM PROPERTY LINE \_\_\_\_\_ PAVEMENT WIDTH \_\_\_\_\_

B.C. HYDRO \_\_\_\_\_ UNDERGROUND CONNECTION \_\_\_\_\_


B.C. TELEPHONE \_\_\_\_\_ UNDERGROUND CONNECTION \_\_\_\_\_

INLAND GAS \_\_\_\_\_

Information Sheets: \_\_\_\_\_

Comments: \_\_\_\_\_

SITE PLAN N.T.S.

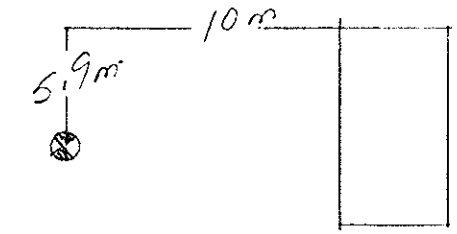

OGILVIE ST.

