

City of Prince George  
HISTORY SHEET

004388801  
844

SHEET NUMBER

Roll Number

Legal: LOT'S 17-18 BLOCK 81 D.L. 937 PLAN 752

Address: 342 Lyon St.

Sanitary Connection: # SIZE MATERIAL INV. CONNECTED

Water Connection # SIZE 20mm MATERIAL Cu. METER CONNECTED

Storm Connection: # SIZE MATERIAL INV. CONNECTED

Cash Receipt No's: WATER SANITARY STORM

CURB FROM PROPERTY LINE PAVEMENT WIDTH


B.C. HYDRO UNDERGROUND CONNECTION

B.C. TELEPHONE UNDERGROUND CONNECTION

INLAND GAS

Information Sheets:

Comments:

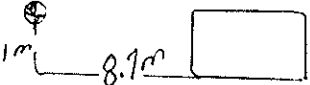

SITE PLAN N.T.S.

