

**City of Prince George  
HISTORY SHEET**

77

SHEET NUMBER

Roll Number 004390814

Legal: LOT'S 2 BLOCK 1 D.L. 1426 PLAN 721

Address: 2608 VICTORIA ST.

Sanitary Connection: # 6626 SIZE 100 mm MATERIAL A.C. INV. 567.027 CONNECTED

Water Connection # 6626 SIZE 20 mm MATERIAL C.U. METER CONNECTED

Storm Connection: # SIZE MATERIAL INV. CONNECTED

Cash Receipt No's: WATER SANITARY 28 STORM

CURB FROM PROPERTY LINE 3.657 m PAVEMENT WIDTH 12.801 m


B.C. HYDRO O/H UNDERGROUND CONNECTION

B.C. TELEPHONE O/H UNDERGROUND CONNECTION

INLAND GAS 3.048 m FROM R.


Information Sheets:

Comments: WITH THAW WIRE.

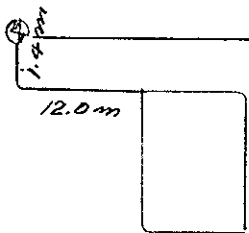

SITE PLAN N.T.S.

24.688 m  
18.897 m  
14.325 m  
11.277 m

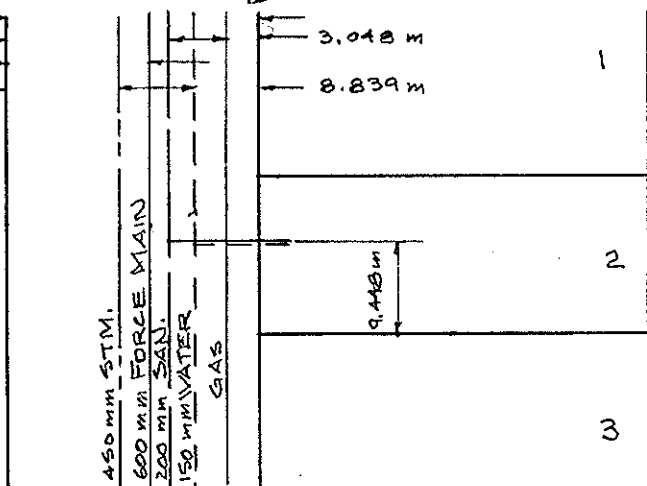

VICTORIA ST.

