

City of Prince George  
HISTORY SHEET

004392426

5

SHEET NUMBER **11913** Roll Number

Legal: LOT'S **A** BLOCK D.L. **823** PLAN **14534**

Address: **1337 PG PULPMILL RD.**

Sanitary Connection: # SIZE MATERIAL INV. CONNECTED

Water Connection # SIZE MATERIAL METER CONNECTED

Storm Connection: # SIZE MATERIAL INV. CONNECTED

Cash Receipt No's: WATER SANITARY STORM

CURB FROM PROPERTY LINE PAVEMENT WIDTH

B.C. HYDRO UNDERGROUND CONNECTION

B.C. TELEPHONE UNDERGROUND CONNECTION

INLAND GAS


Information Sheets:

Comments:

SITE PLAN N.T.S.

PULPMILL RD.

P/L

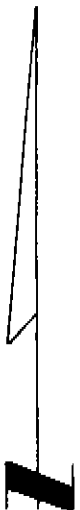

1

A

ROAD

P/L