

City of Prince George HISTORY SHEET

SHEET NUMBER

Roll Number 004394887

Legal: LOT'S 5 BLOCK D.L. 753 PLAN 23765

Address: 5477 MORIARTY CRES

Sanitary Connection: # SIZE 4" MATERIAL P.V.C. INV. CONNECTED

Water Connection # SIZE 3/4" MATERIAL COPPER METER CONNECTED

Storm Connection: # SIZE MATERIAL INV. CONNECTED

Cash Receipt No's: WATER SANITARY STORM

CURB FROM PROPERTY LINE 16' PAVEMENT WIDTH 34'


B.C. HYDRO 3' UNDERGROUND CONNECTION

B.C. TELEPHONE 3' UNDERGROUND CONNECTION

INLAND GAS 10'

Information Sheets:




Comments: 66' R/W.

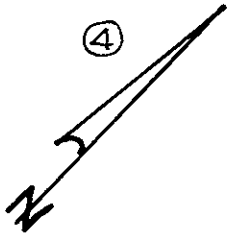

SITE PLAN N.T.S.

5

6

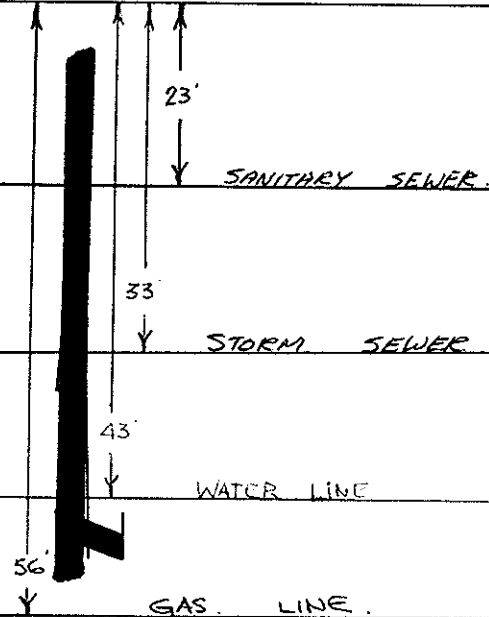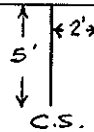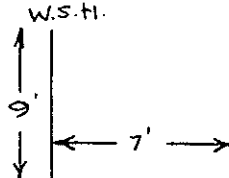

MORIARTY CRES.