

City of Prince George  
HISTORY SHEET

004-17226

SHEET NUMBER **7639** Roll Number

Legal: LOT'S 1 BLOCK D.L. 4038 PLAN 12241

Address: 4991 OLD SUMMIT LAKE RD.

Sanitary Connection: # SIZE MATERIAL INV. CONNECTED

Water Connection # SIZE MATERIAL METER CONNECTED

Storm Connection: # SIZE MATERIAL INV. CONNECTED

Cash Receipt No's: WATER SANITARY STORM

CURB FROM PROPERTY LINE PAVEMENT WIDTH

B.C. HYDRO UNDERGROUND CONNECTION


B.C. TELEPHONE UNDERGROUND CONNECTION

INLAND GAS

Information Sheets:

Comments:

SITE PLAN N.T.S.

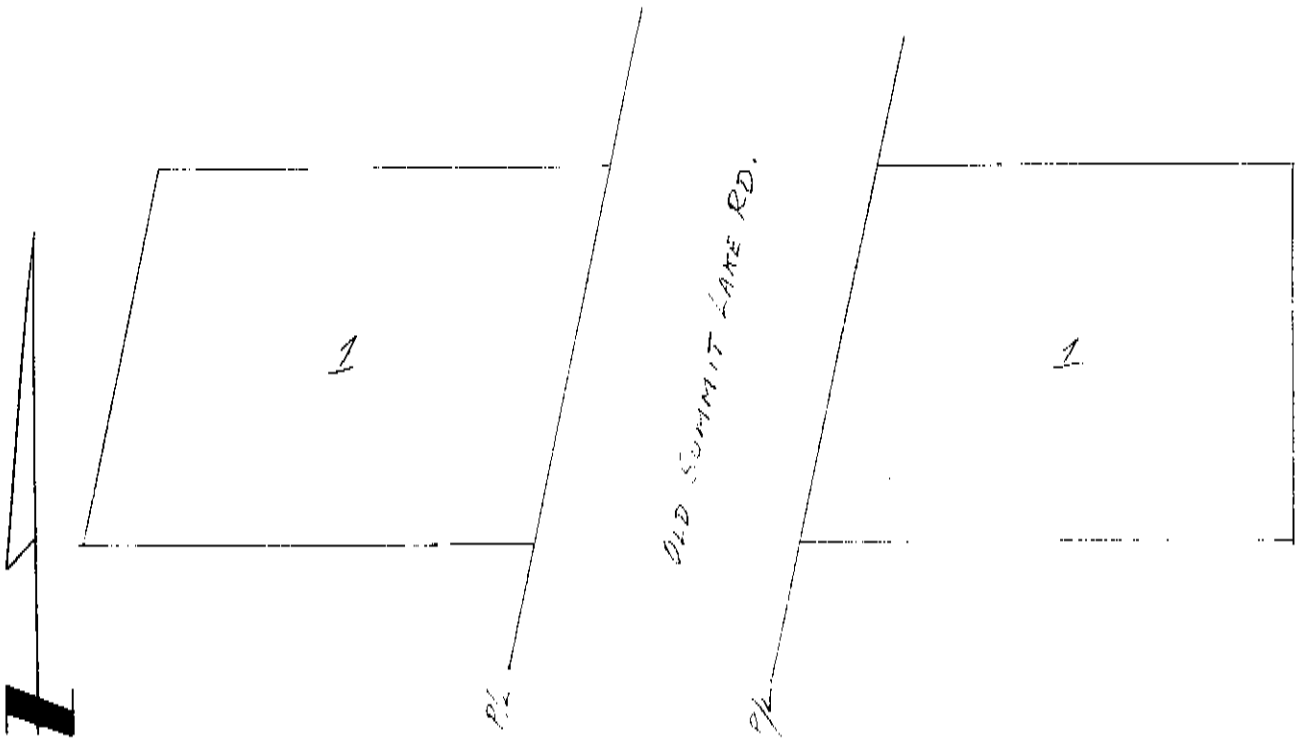

4991