



City of Prince George  
**History Sheet**

PID:	004397355
SD/MU:	
WO:	

Civic Address: 7192 Moose Road

Legal Description: Lot: 42 District Lot: 1599 Plan: 13527


Service Type	Diameter (mm)	Material	Invert Elev at main (m)	Invert Elev at property line (m)	Invert Depth at service end (m)	Distance into property (m)	Installation Date
Sanitary	100mm	PVC	-	-	2.61	-	August 1984
Water	20mm	Copper	-	-	-	-	October 1979
Storm	N/A	N/A	-	-	-	-	

Service Connection Location				Sanitary (m)	Storm (m)
Distance from downstream San MH	4360	towards upstream San MH	4363	63.08	
Distance from downstream Stm MH	-	towards upstream Stm MH	-		

Power	Size	Communications	Size	Cable	Size	Gas	Size
BC Hydro	-	Telus	-	Shaw	-	FortisBC	-
Overhead Service		Overhead Service		Overhead Service			

Installed by:	Survey Date:	-
Comments:		

**NOT TO SCALE** The information contained herein is for internal use only.  
Not to be relied on unless confirmed by site inspection and/or investigation.

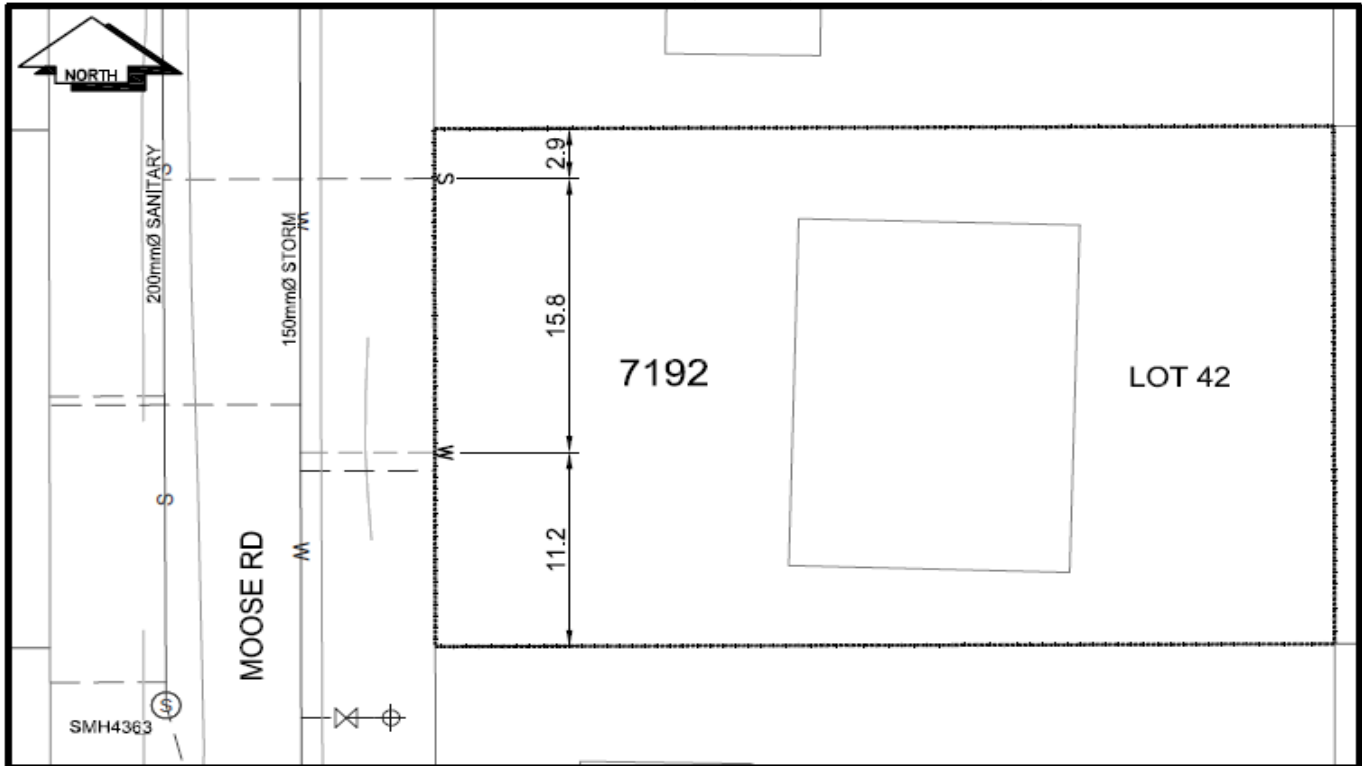

LEGEND:	
CS <sup>o</sup>	CURB STOP
CO <sup>o</sup>	CLEAN OUT
⊗	WATER VALVE
— W —	WATER SERVICE
— S —	SANITARY SERVICE
⊗	FIRE HYDRANT
— S —	STORM SERVICE
— G —	GAS
---	ENCUMBRANCE

**NOT TO SCALE**