

City of Prince George HISTORY SHEET

SHEET NUMBER

Roll Number 004397762

Legal: LOT'S 10 BLOCK _____ D.L. 753 PLAN 19163

Address: 5123 DAKHOUSIE DR.

Sanitary Connection: # _____ SIZE _____ MATERIAL _____ INV. _____ CONNECTED _____

Water Connection # _____ SIZE 20mm MATERIAL CU METER _____ CONNECTED _____

Storm Connection: # _____ SIZE _____ MATERIAL _____ INV. _____ CONNECTED _____

Cash Receipt No's: WATER _____ SANITARY _____ STORM _____

CURB FROM PROPERTY LINE _____ PAVEMENT WIDTH _____


B.C. HYDRO _____ UNDERGROUND CONNECTION _____

B.C. TELEPHONE _____ UNDERGROUND CONNECTION _____

INLAND GAS _____

Information Sheets: _____

Comments: _____

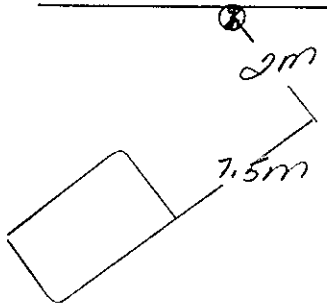

SITE PLAN N.T.S.

