

City of Prince George HISTORY SHEET

SHEET NUMBER

Roll Number 004317, 20

Legal: LOT'S 139 BLOCK _____ D.L. 2507 PLAN 20916

Address: 4370 EAGLENEST CRES.

Sanitary Connection: # 8679 SIZE 100mm MATERIAL A.C. INV. _____ CONNECTED _____

Water Connection # 8679 SIZE 20mm MATERIAL C.U. METER _____ CONNECTED _____

Storm Connection: # _____ SIZE _____ MATERIAL _____ INV. _____ CONNECTED _____

Cash Receipt No's: WATER _____ SANITARY _____ STORM _____

CURB FROM PROPERTY LINE 4.877m PAVEMENT WIDTH 10.363m

B.C. HYDRO U/G UNDERGROUND CONNECTION _____


B.C. TELEPHONE U/G UNDERGROUND CONNECTION _____

INLAND GAS AS SHOWN

Information Sheets: _____

Comments: _____

**THE INFORMATION CONTAINED HEREIN IS FOR INTERNAL USE ONLY.
NOT TO BE RELIED UPON UNLESS CONFIRMED BY SITE INSPECTION AND/OR INVESTIGATION**

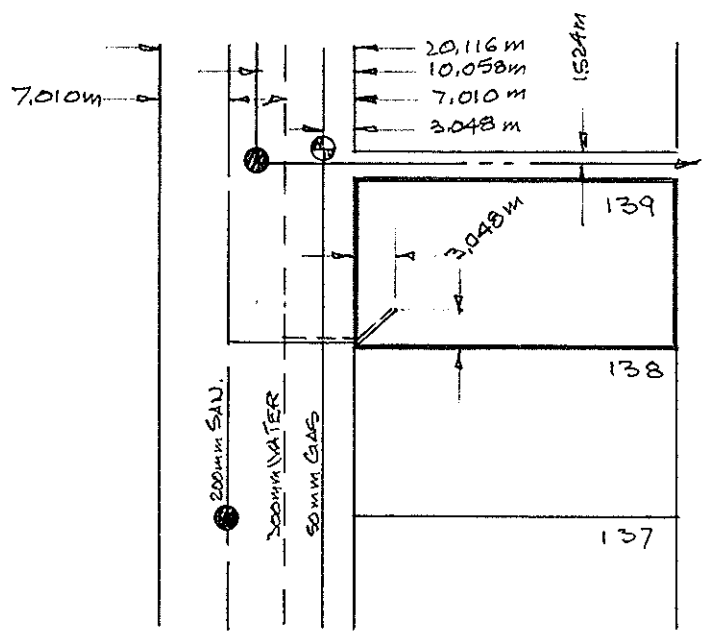

EAGLENEST
CRES.