



**City of Prince George
HISTORY SHEET**

127863

FM

| | | | | |
|------------------------------|----------|------------------------|----------|-----------------|
| SHEET NUMBER | | Roll Number | | |
| Legal: | LOT'S | BLOCK | D.L. | PLAN |
| | 232 | — | 482 | 20916 |
| Address: 4488 URQUHART CRES. | | | | |
| Sanitary Connection: | # | SIZE | MATERIAL | INV. CONNECTED |
| | 8718 | 100mm | A.C. | |
| Water Connection: | # | SIZE | MATERIAL | METER CONNECTED |
| | 8718 | 20mm | COPPER | |
| Storm Connection: | # | SIZE | MATERIAL | INV. CONNECTED |
| | | | | |
| Cash Receipt No's: | WATER | SANITARY | STORM | |
| | | | | |
| CURB FROM PROPERTY LINE | 4.877m | PAVEMENT WIDTH | 10.363m | |
| B.C. HYDRO | U/G | UNDERGROUND CONNECTION | | |
| B.C. TELEPHONE | U/G | UNDERGROUND CONNECTION | | |
| INLAND GAS | AS SHOWN | | | |
| Information Sheets: | | | | |
| Comments: WITH THAW WIRE. | | | | |

**THE INFORMATION CONTAINED HEREIN IS FOR INTERNAL USE ONLY.
NOT TO BE RELIED UPON UNLESS CONFIRMED BY SITE INSPECTION AND/OR INVESTIGATION**

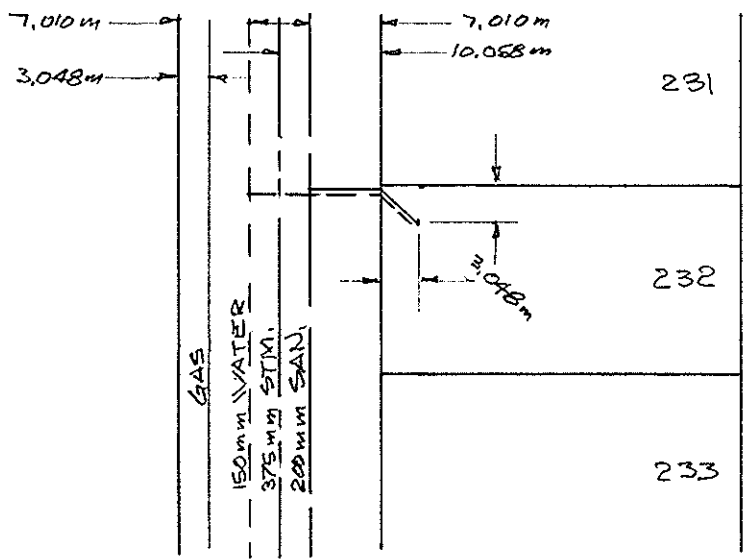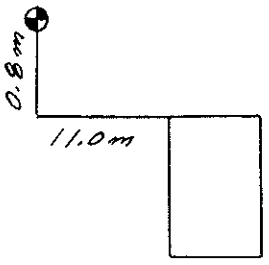

URQUHART
CRES.