

**City of Prince George  
HISTORY SHEET**

309417542

SHEET NUMBER

Roll Number

569

Legal: LOT'S 17-18 BLOCK 89 D.L. 937 PLAN 752

Address: 236 EWERT ST.

Sanitary Connection: # 3059 SIZE 100 mm MATERIAL A.C. INV. 587.613 CONNECTED

Water Connection # 3222 SIZE 20 mm MATERIAL CU. METER CONNECTED

Storm Connection: # SIZE MATERIAL INV. CONNECTED

Cash Receipt No's: WATER SANITARY STORM

CURB FROM PROPERTY LINE 4.877 m PAVEMENT WIDTH 10.363 m

B.C. HYDRO O/H UNDERGROUND CONNECTION



B.C. TELEPHONE O/H UNDERGROUND CONNECTION

INLAND GAS 1.524 m FROM R IN LANE

Information Sheets:

Comments: WITH THAW WRE.

**THE INFORMATION CONTAINED HEREIN IS FOR INTERNAL USE ONLY.  
NOT TO BE RELIED UPON UNLESS CONFIRMED BY SITE INSPECTION AND/OR INVESTIGATION**

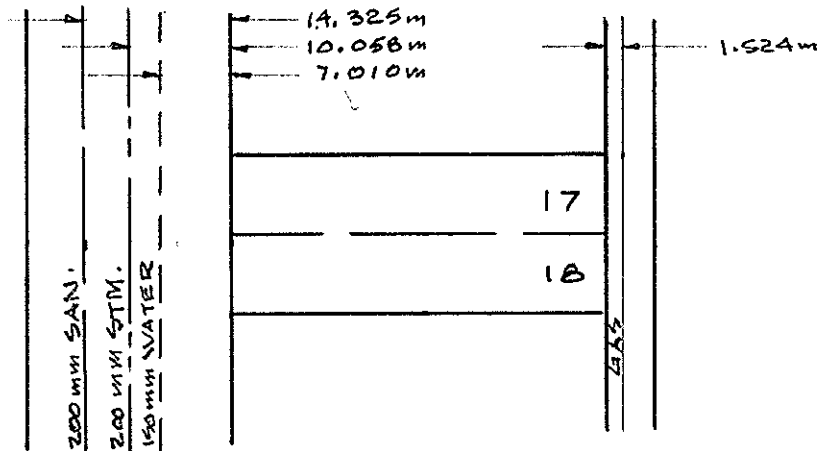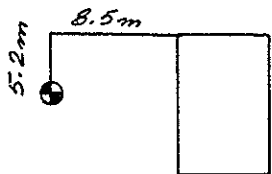

EWERT ST.

