

**City of Prince George
HISTORY SHEET**

1974 S.F.G. Assessment
961

SHEET NUMBER **8131** Roll Number **211**

Legal: LOT'S **13, 14, 20** BLOCK **9** D.L. **933** PLAN **727**

Address: **2633 ~~8th~~ Street MOYIE ST**

Sanitary Connection: # _____ SIZE **4"** MATERIAL **AC** INV. _____ CONNECTED **1971**

Water Connection # _____ SIZE **3/4"** MATERIAL **CU** METER _____ CONNECTED **1956**

Storm Connection: # _____ SIZE _____ MATERIAL _____ INV. _____ CONNECTED _____

Cash Receipt No's: WATER **pol.** SANITARY **pol.** STORM _____

CURB FROM PROPERTY LINE _____ PAVEMENT WIDTH _____

B.C. HYDRO **04** UNDERGROUND CONNECTION _____

B.C. TELEPHONE **04** UNDERGROUND CONNECTION _____

INLAND GAS _____

Information Sheets: _____



Comments: _____

SITE PLAN N.T.S.

Sanitary

Water

3.4m
5.9m

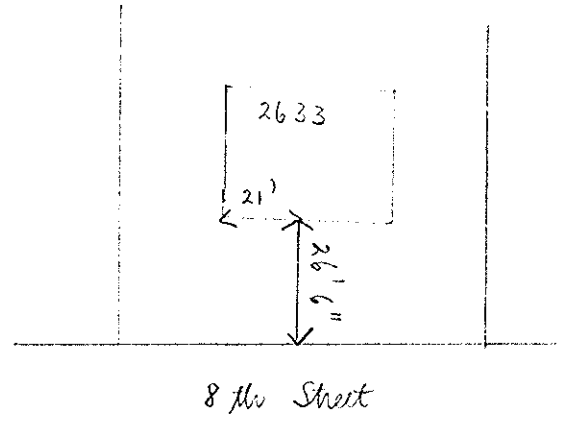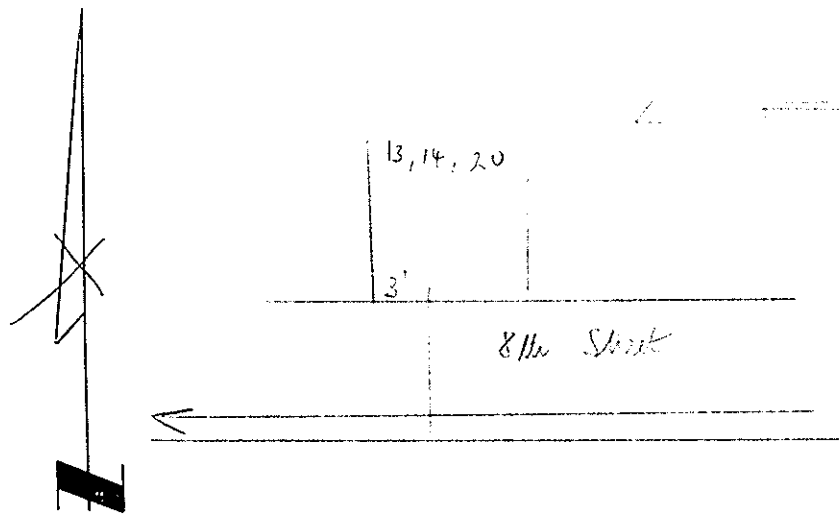

8th Street