

**City of Prince George  
HISTORY SHEET**

004432622

SHEET NUMBER **87** Roll Number **475-000**

Legal: LOT'S **A** BLOCK **D.L. 343** PLAN **5652**

Address: **FERGUSON LAKE SAWMILLS LTD** **114 GEORGE ST. PRINCE GEORGE, P.C. 138-1414 GEORGE ST.**

Sanitary Connection: # **2065** SIZE **150mm** MATERIAL **VT** INV. **---** CONNECTED **---**

Water Connection # **12-182** SIZE **1"** MATERIAL **---** METER **---** CONNECTED **---**

Storm Connection: # **---** SIZE **---** MATERIAL **---** INV. **---** CONNECTED **---**

Cash Receipt No's: WATER **3010** SANITARY **---** STORM **---**

CURB FROM PROPERTY LINE **10'** PAVEMENT WIDTH **60'**

B.C. HYDRO **O.H.** UNDERGROUND CONNECTION **---**


B.C. TELEPHONE **O.H.** UNDERGROUND CONNECTION **---**

INLAND GAS **ON LANE 3"  $\phi$  MAIN.**

Information Sheets: **---**

Comments: **---**

SITE PLAN N.T.S.

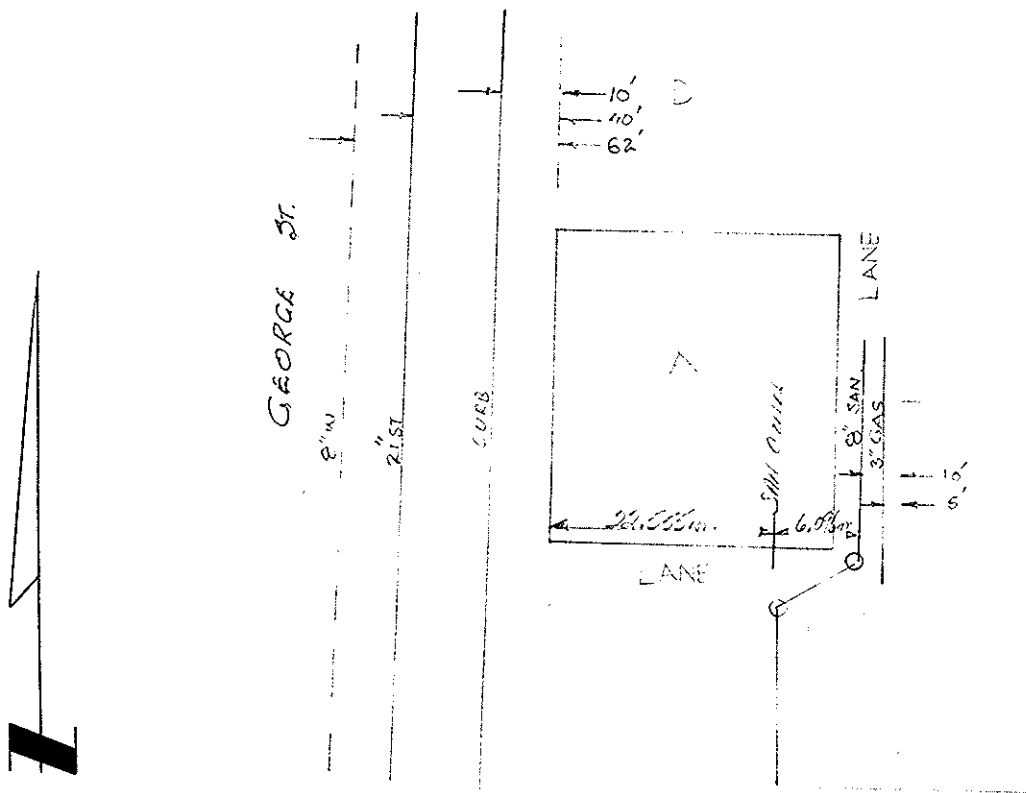

**2ND AVE.**