

**City of Prince George
HISTORY SHEET**

467

SHEET NUMBER

Roll Number

Legal: LOT'S 12, 13 BLOCK 50 D.L. 936 PLAN 696

Address: 817 Johnson St.

Sanitary Connection: # 3451 SIZE MATERIAL INV. CONNECTED

Water Connection # 3408 SIZE 20mm MATERIAL Cu. METER CONNECTED

Storm Connection: # SIZE MATERIAL INV. CONNECTED

Cash Receipt No's: WATER SANITARY STORM

CURB FROM PROPERTY LINE 5m PAVEMENT WIDTH


B.C. HYDRO UNDERGROUND CONNECTION

B.C. TELEPHONE UNDERGROUND CONNECTION

INLAND GAS

Information Sheets: RP51, Eng 43 No. 1461

Comments:

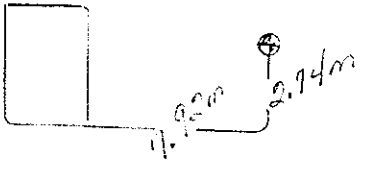

SITE PLAN N.T.S.

